

PERRY  
D 11  
12-31-69

MISSISSIPPI  
BOARD OF WATER COMMISSIONERS  
416 North State Street  
Jackson, Mississippi 39201  
WATER WELL DRILLERS LOG

CODED  
CODED

12-31 1969 date well completed  
SJR firm name  
Perry county well located


LANDOWNER	description of formations encountered	from	to
Prospect Tung Farm Richter, Miss (mailing address)	Clay Fine Sand Gravelly clay P.D. FEWD Sand	0 15 22 34 50	15 22 34 50
<b>WELL LOCATION:</b> sec. <u>14</u> T. <u>4</u> N. R. <u>11</u> E. S. W. <sup>W</sup> <u>5 3/8</u> miles <u>SE</u> of <u>Pinnett</u> (distance) (direction) (nearest town)			
<b>WELL PURPOSE:</b> <u>Home</u> (home, irrigation, municipal, industrial)			
<b>WELL COMPLETION DATA:</b>			
(1) diameter (inches) <u>2"</u>			
(2) total depth (feet) <u>50 ft</u>			
(3) static water level (feet) <u>24</u> below top of ground. above			
(4) casing <u>plastic</u> , <u>4.5</u> (material) (depth)			
<u>2"</u> If telescope see back. (size)			
(5) screen <u>5 ft</u> , <u>4.5</u> (length) (depth to top)			
<u>2"</u> , <u>plastic</u> (size) (material)			
(6) pump <u>1</u> , <u>9000</u> (HP) (yield gpm)			
<u>del</u> (type power)			
(7) electric log _____ (yes or no)			
_____ (organization running log)			
(8) how well bottom plugged <u>None</u>			
DRILLERS REMARKS:			

JAN 20 1970

MISS. Bd. of  
WATER COMMISSIONERS

If well telescopes please sketch and show depths.

GROUND LEVEL

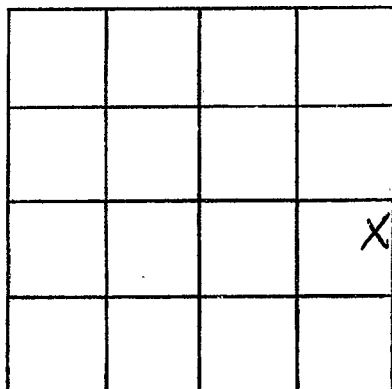

SECTION 14

Please indicate well location X.

ADDITIONAL INFORMATION

If more than one screen, show locations of each on sketch.