

Perry Co
 D 12
 2-26-70

MISSISSIPPI
 BOARD OF WATER COMMISSIONERS
 416 North State Street
 Jackson, Mississippi 39201
 WATER WELL DRILLERS LOG

CODED

Feb. 26 1970 date well completed S+R firm name Perry county well located

LANDOWNER: Mr. Harvard
Pt 2
Rumelton, Miss.
 (mailing address)

description of formations encountered	from	to
<u>Clay</u>	<u>0</u>	<u>14</u>
<u>Fine Sand</u>	<u>14</u>	<u>20</u>
<u>Shale + S.S.</u>	<u>20</u>	<u>35</u>
<u>Clay</u>	<u>35</u>	<u>37</u>
<u>Fine Sand</u>	<u>37</u>	<u>44</u>
<u>Sh + Cw Sand</u>	<u>44</u>	<u>65</u>

WELL LOCATION:
 sec. 4 T. 4 (N) S R. 11 (E) W
3 miles SS of Rumelton
 (distance) (direction) (nearest town)

WELL PURPOSE: Home
 (home, irrigation, municipal, industrial)

- WELL COMPLETION DATA:
- (1) diameter (inches) 2"
 - (2) total depth (feet) 65
 - (3) static water level (feet) 15 below above top of ground.
 - (4) casing plastic, 60
 (material) (depth)
2" If telescope see back.
 (size)
 - (5) screen 5 ft, 60
 (length) (depth to top)
2" plastic
 (size) (material)
 - (6) pump 3/4 700 G.P.M.
 (HP) (yield gpm)
1/2
 (type power)
 - (7) electric log
 (yes or no)

 (organization running log)
 - (8) how well bottom plugged Water

CODED


MAR 24 1970

MISS. BD. OF
 WATER COMMISSIONERS

DRILLERS REMARKS:

If well telescopes please sketch and show depths.

GROUND LEVEL

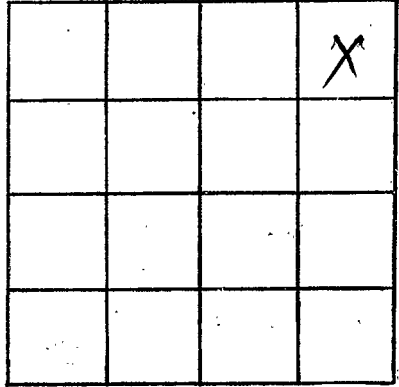

SECTION 24

Please indicate well location X.

ADDITIONAL INFORMATION

If more than one screen, show locations of each on sketch.