

Perry
D 14
6-70

MISSISSIPPI
BOARD OF WATER COMMISSIONERS
416 North State Street
Jackson, Mississippi 39201

CODED

WATER WELL DRILLERS LOG

June 1970 date well completed Peoples Drilling Co firm name Perry county well located

LANDOWNER: Wm L Sigert
Rt 3
Richton, Miss
(mailing address)

WELL LOCATION:
sec. 2 T. 4 (N) R. 11 (W)
8 miles W of Richton
(distance) (direction) (nearest town)

WELL PURPOSE: Home
(home, irrigation, municipal, industrial)

WELL COMPLETION DATA:

(1) diameter (inches) 4

(2) total depth (feet) 525

(3) static water level (feet) 95 (below/above top of ground)

(4) casing iron, 210' (material) (depth)
4" (size) if telescope see back.

(5) screen 4', 521 (length) (depth to top)
2", stainless steel (size) (material)

(6) pump 1/2, 10 (HP) (yield gpm)
electric (type power)

(7) electric log no (yes or no)
(organization running log)

(8) how well bottom plugged Back
Wash valve

description of formations encountered	from	to
<u>yellow sandy clay</u>	<u>0</u>	<u>18</u>
<u>Blue shale</u>	<u>18</u>	<u>73</u>
<u>Green sand & sandy shale</u>	<u>73</u>	<u>132</u>
<u>Blue shale</u>	<u>132</u>	<u>241</u>
<u>Fine white sand</u>	<u>241</u>	<u>255</u>
<u>Blue sandy shale</u>	<u>255</u>	<u>362</u>
<u>Green sandy shale</u>	<u>362</u>	<u>380</u>
<u>Brown shale</u>	<u>380</u>	<u>385</u>
<u>Green shaly sand</u>	<u>385</u>	<u>420</u>
<u>Fine gray sand</u>	<u>420</u>	<u>480</u>
<u>Coarse sand</u>	<u>480</u>	<u>525</u>

CODED


JUL 7 1970

MISS. BD. OF WATER COMMISSIONERS

DRILLERS REMARKS:

If well telescopes please sketch and show depths.

GROUND LEVEL

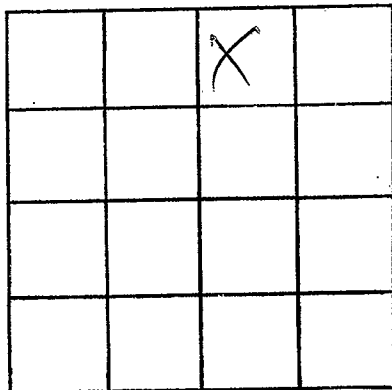

SECTION 2

Please indicate well location X.

ADDITIONAL INFORMATION

If more than one screen, show locations of each on sketch.