

PERRY
 D 16
 9-3-70

MISSISSIPPI
 BOARD OF WATER COMMISSIONERS
 416 North State Street
 Jackson, Mississippi 39201

CODED

WATER WELL DRILLERS LOG

date well completed Sept 3 19 70 firm name Cochran Drilling Co. county well located Perry

LANDOWNER:

Mr Samuel Hensley
Route 2 Hattiesburg Miss
 (mailing address)

description of formations encountered

from to

<u>Sand clay</u>	<u>0</u>	<u>6</u>
<u>Clay</u>	<u>6</u>	<u>18</u>
<u>Sand</u>	<u>18</u>	<u>32</u>

WELL LOCATION:

sec. 6 T. 4 N. R. 11 E.
3 miles S of Amelita
 (distance) (direction) (nearest town)

WELL PURPOSE: home
 (home, irrigation, municipal, industrial)

WELL COMPLETION DATA:

- (1) diameter (inches) 2
- (2) total depth (feet) 32
- (3) static water level (feet) 18 ^{below} top of ground.
- (4) casing PVC 27
 (material) (depth)
 (size) if telescope see back.
- (5) screen 5 27
 (length) (depth to top)
2 PVC
 (size) (material)
- (6) pump 1 6
 (HP) (yield gpm)
Electric
 (type power)
- (7) electric log No
 (yes or no)
- (organization running log)
- (8) how well bottom plugged Valve

CODED


JAN 22 1971

DRILLERS REMARKS:

MISS. DB. OF
 WATER COMMISSIONERS

If well telescopes please sketch and show depths.

GROUND LEVEL

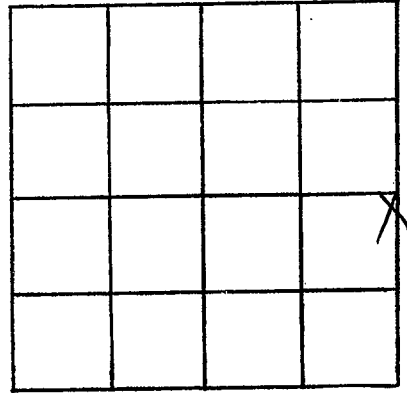

SECTION 6

Please indicate well location X.

ADDITIONAL INFORMATION

If more than one screen,
show locations of each on sketch.