

PERRY
D17
1-12-71

MISSISSIPPI
BOARD OF WATER COMMISSIONERS
416 North State Street
Jackson, Mississippi 39201

CODED

WATER WELL DRILLERS LOG

Jan 12 1971 date well completed
Wachman Drilling Service Perry firm name
county well located

LANDOWNER: Mr. G
Mr. Alvin Watkins
Route 2 Natchez, Miss.
(mailing address)

description of formations encountered	from to	
	feet	feet
Soil	0	3
Sandy clay	3	12
Clay white	12	34
Sand Fine Blue	34	42
Clay Blue	42	58
Sand white	58	85

WELL LOCATION:
sec. 6 T. 4 N. R. 11 E.
2 miles SW. of Punnett
(distance) (direction) (nearest town)

WELL PURPOSE: Home
(home, irrigation, municipal, industrial)

- WELL COMPLETION DATA:
- (1) diameter (inches) 2
 - (2) total depth (feet) 85
 - (3) static water level (feet) 65 below top of ground.
 - (4) casing MC 80
(material) (depth)
(size) if telescope see back.
 - (5) screen 5 80
(length) (depth to top)
2 PVC
(size) (material)
 - (6) pump 1 5
(HP) (yield gpm)
Star
(type power)
 - (7) electric log No
(yes or no)
(organization running log)
 - (8) how well bottom plugged Very

CODED


JAN 22 1971

DRILLERS REMARKS:

MISS. BD. OF
WATER COMM.

If well telescopes please sketch and show depths.

GROUND LEVEL

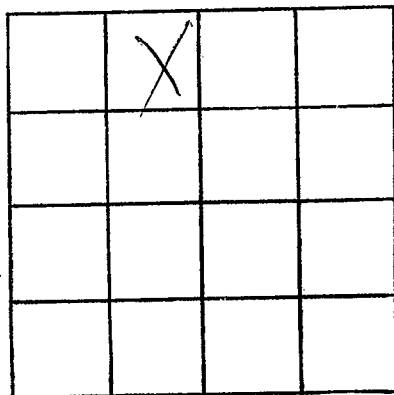

SECTION 6

Please indicate well location X.

ADDITIONAL INFORMATION

If more than one screen,
show locations of each on sketch.