

D18

WATER WELL DRILLERS LOG

CODED

5-22-63

Date: 5-22, 1963, Driller: W. G. Moore, County Perry

389/19

(Name)

(1) Owner of Land: A. V. Carter (Name)

Wattsburg Miss RT 2 Box 346 (Address)

(2) Location: 1/4, 1/4, Sec. 8 T. 4 R. 11, miles of RR NW 1/4 (distance, direction, Nearest Town)

(3) Topography: (Hilly) (Flat) (Level) [Level checked]

(4) Purpose of Well: Horse use (Domestic Irrigation, Municipal, Industrial, Other)


Description & Color of Materials Sand, Clay, Red Clay, Shell, etc.	Thick- ness Feet	Depth Feet
Surface 0	10	
Sand & silt 10	22	
Clay topped with sand 10	40	
Clay Blue 40	33	
Sand concrete top 53	60	

Information upon completion of well:

- (1) Diameter 2" inches.
- (2) Total Depth 60 feet.
- (3) Water Level 20 feet below top of ground.
- (4) Cased to 54, Size 2"
- (5) Screen: Size 2", Length 6"
- (6) Were any formations sealed against pollution? yes, no.

If YES depth of formation
Why
Drillers Remarks:

CODED

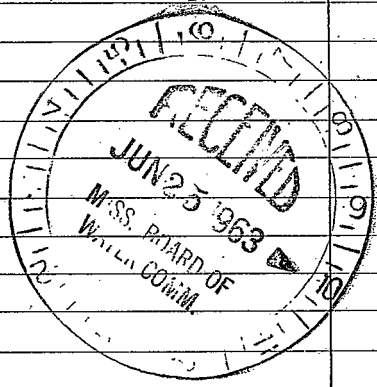

(Use Back Side)

Well No. 19

100

101

102

200