

BD20

10-65

WATER WELL DRILLERS LOG

CODED

Date: Oct, 1965, Driller: Peoples Drilling Co County Perry

(Name)

393/3

(1) Owner of Land: Frank Reedy (Name)

Rt 3 Richters (Address)

(2) Location: 1/4, 1/4, Sec. 12 T9 R11

Back Creek miles (direction) of (Nearest Town)

(3) Topography: Hilly (Hilly) (Flat) (Level)

(4) Purpose of Well: Home (Domestic Irrigation Municipal, Industrial, Other)

Description & Color of Materials Sand, Clay, Red Clay, Shell, etc.	Thick- ness Feet	Depth Feet
Red clay	15	15
White clay	60	75
Blue clay	6	81
Yellow sand		
Coarse gravel	3	90

Information upon completion of well:

(1) Diameter 2 inches.

(2) Total Depth 90 feet.

(3) Water Level 70 feet below top of ground.

(4) Cased to 84', Size 2"

(5) Screen: Size 2", Length 6'

(6) Were any formations sealed against pollution?


yes, no.

If YES depth of formation

Why

Drillers Remarks:

CODED

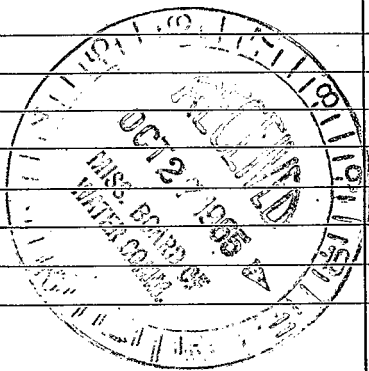

(Use Back Side)

Well No.

100