

PERRY
D 23
7-12-63

MISSISSIPPI BOARD OF WATER COMMISSIONERS

WATER WELL DRILLERS LOG

CODED

Date: 7-12-63, 1963, Driller: W. H. Moore County Perry
904127 (Name)

(1) Owner of Land: R. C. Travis
(Name)
Willingburg Miss RTG
(Address)

(2) Location: 1/4, 1/4, Sec. 19 9 11
_____ miles _____ of _____
(distance) (direction) (Nearest Town)

(3) Topography: (Hilly) (Flat) (Level)

(4) Purpose of Well: Home use
(Domestic Irrigation
Municipal, Industrial, Other)

Description & Color of Materials Sand, Clay, Red Clay, Shell, etc.	Thick- ness Feet	Depth Feet
<u>Surface</u>	<u>0</u>	<u>15</u>
<u>Sand</u>	<u>15</u>	<u>16</u>
<u>Clay, Yellow</u>	<u>16</u>	<u>56</u>
<u>Sub Stone</u>	<u>56</u>	<u>78</u>
<u>Sand</u>	<u>78</u>	<u>99</u>


Information upon completion of well:

- (1) Diameter 2" inches.
- (2) Total Depth 99 feet.
- (3) Water Level 50 feet below top of ground.
- (4) Cased to 95, Size 2"
- (5) Screen: Size 2", Length 6
- (6) Were any formations sealed against pollution?
_____ yes, _____ no.

If YES depth of formation _____
Why _____

Drillers Remarks: _____

CODED

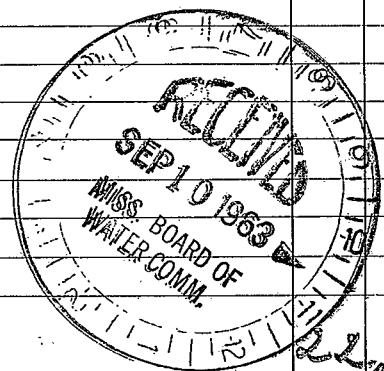

(Use Back Side)

Well No. 222

