

PERRY
AD 24
4-65

MISSISSIPPI BOARD OF WATER COMMISSIONERS

WATER WELL DRILLERS LOG

Not Indexed
CODED

Forrest?

Date: April, 1965, Driller: Peoples Drilling Co. Perry
192/17 392/35 (Name)

(1) Owner of Land: MAMIE J. JONES
(Name)
Richton
(Address)

(2) Location: 1/4, 1/4, Sec. 2 T 4 R 11 W
15 miles W, of Richton
(distance) (direction) (Nearest Town)

(3) Topography: Hilly
(Hilly) (Flat) (Level)

(4) Purpose of Well: Home
(Domestic Irrigation
Municipal, Industrial, Other)

Description & Color of Materials Sand, Clay, Red Clay, Shell, etc.	Thick- ness Feet	Depth Feet
<u>Yellow Sandy clay</u>	<u>12</u>	<u>12</u>
<u>Blue clay</u>	<u>72</u>	<u>84</u>
<u>Blue Sandy shale</u>	<u>59</u>	<u>143</u>
<u>White sand</u>	<u>33</u>	<u>176</u>

CODED

Information upon completion of well:

(1) Diameter 2" inches.


(2) Total Depth 176 feet.

(3) Water Level 160 feet below top of ground.

(4) Cased to 170', Size 2"

(5) Screen: Size 2", Length 6'

(6) Were any formations sealed against pollution?
_____ yes, _____ no.

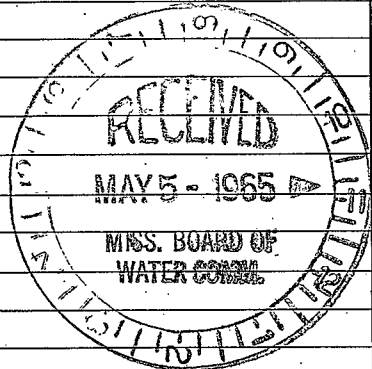

If YES depth of formation _____

Why _____

Drillers Remarks: _____

Well No.

(Use Back Side)

