

MISSISSIPPI
BOARD OF WATER COMMISSIONERS
416 North State Street
Jackson, Mississippi 39201

CODED

WATER WELL DRILLERS LOG

PERRY
D25
5-10-71

May 10 1971 Packard Drilling Co. Perry
date well completed firm name county well located

LANDOWNER: Well # 2
Chin Watkins
Route 8 Natchez
(mailing address)

description of formations encountered	from	to
<u>top soil</u>	<u>0</u>	<u>2</u>
<u>Red Clay</u>	<u>2</u>	<u>6</u>
<u>Sand</u>	<u>6</u>	<u>14</u>
<u>White Clay</u>	<u>14</u>	<u>28</u>
<u>Blue Clay</u>	<u>28</u>	<u>56</u>
<u>Sand</u>	<u>56</u>	<u>88</u>

WELL LOCATION:
sec. 6 T. 4 (N) R. 11 (E)
2 1/2 miles SW of Panetta
(distance) (direction) (nearest town)

WELL PURPOSE: Home
(home, irrigation, municipal, industrial)

WELL COMPLETION DATA:

- (1) diameter (inches) 2
- (2) total depth (feet) 85
- (3) static water level (feet) 60 below top of ground.
- (4) casing PVC 80
(material) (depth)
(size) if telescope see back.
- (5) screen 5 80
(length) (depth to top)
3 PVC
(size) (material)
- (6) pump 1 6
(HP) (yield gpm)
Electric
(type power)
- (7) electric log No
(yes or no)
(organization running log)
- (8) how well bottom plugged Value

CODED


JUN 20 1971

DRILLERS REMARKS:

MISS. BD. OF
WATER COMM.

If well telescopes please sketch and show depths.

GROUND LEVEL

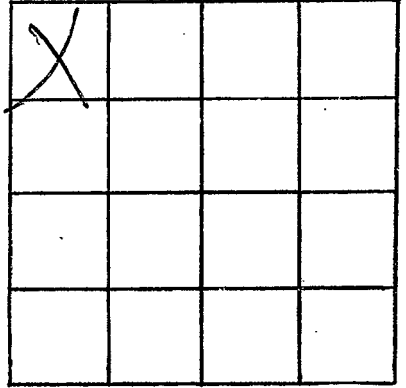

SECTION 6

Please indicate well location X.

ADDITIONAL INFORMATION

If more than one screen,
show locations of each on sketch.