

PERRY
D26
5-21-71

MISSISSIPPI
BOARD OF WATER COMMISSIONERS
416 North State Street
Jackson, Mississippi 39201

CODED

WATER WELL DRILLERS LOG

May 21, 1971 Cochran Drilling Co. Perry
date well completed firm name county well located

LANDOWNER:
Clair Watkins
Route 8 Hattiesburg
(mailing address)

| description of formations encountered | from | to |
|---------------------------------------|-----------------|------------|
| | <u>Top Soil</u> | <u>0</u> |
| <u>Red Clay</u> | <u>5</u> | <u>12</u> |
| <u>Red Sand</u> | <u>12</u> | <u>22</u> |
| <u>White Clay</u> | <u>22</u> | <u>41</u> |
| <u>Blue Clay</u> | <u>41</u> | <u>86</u> |
| <u>Sand</u> | <u>86</u> | <u>105</u> |

WELL LOCATION:
sec. 6 T. 4 N. R. 11 E.
2 1/2 miles SW of Perry
(distance) (direction) (nearest town)

WELL PURPOSE: Home
(home, irrigation, municipal, industrial)

- WELL COMPLETION DATA:
- (1) diameter (inches) 2
 - (2) total depth (feet) 105
 - (3) static water level (feet) 78 ^{below} above top of ground.
 - (4) casing pvc, 100
(material) (depth)
(size) If telescope see back.
 - (5) screen 5, 100
(length) (depth to top)
2, pvc
(size) (material)
 - (6) pump 1, 5
(HP) (yield gpm)
elec
(type power)
 - (7) electric log No
(yes or no)
(organization running log) Uplog
 - (8) how well bottom plugged Uplog

CODED


JUN 28 1971

DRILLERS REMARKS:

MISS. Bd. OF
WATER COMMISSIONERS

If well telescopes please sketch and show depths.

GROUND LEVEL

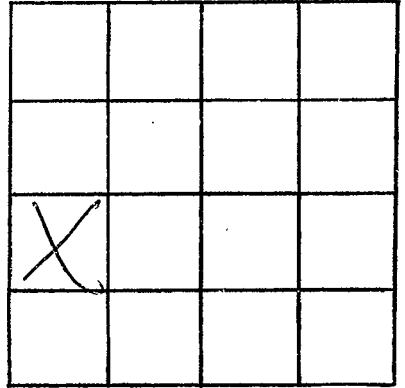

SECTION ~~06~~ 06

Please indicate well location X.

ADDITIONAL INFORMATION

If more than one screen,
show locations of each on sketch.