

Perry
D 28
11-4-71

MISSISSIPPI
BOARD OF WATER COMMISSIONERS
416 North State Street
Jackson, Mississippi 39201

FEB - 7 1972

WATER WELL DRILLERS LOG **CODED**


11-4 1971 date well completed
Pattina's firm name
Perry county well located

LANDOWNER:	description of formations encountered	from	to
<i>Clyburn Tring</i>	<i>Clay</i>	<i>0</i>	<i>28</i>
	<i>Fine Sand</i>	<i>28</i>	<i>31</i>
	<i>Clay</i>	<i>31</i>	<i>40</i>
	<i>Sand & P. Shell</i>	<i>40</i>	<i>62</i>
(mailing address)			
WELL LOCATION:			
sec <i>19</i> T <i>4</i> N <i>11</i> E			
<i>8</i> miles <i>W</i> of <i>Pattina</i>			
(distance) (direction) (nearest town)			
WELL PURPOSE:			
(home) irrigation, municipal, industrial			
WELL COMPLETION DATA:			
(1) diameter (inches) <i>2"</i>			
(2) total depth (feet) <i>62</i>			
(3) static water level (feet) <i>40</i> below top of ground.			
(4) casing <i>plastic</i> , <i>52</i> , (material) (depth)			
<i>2"</i> (size) if telescope see back.			
(5) screen <i>10 ft</i> , <i>52</i> (length) (depth to top)			
<i>2"</i> (size), <i>plastic</i> (material)			
(6) pump (HP) (yield gpm)			
(type power)			
(7) electric log (yes or no)			
(organization running log)			
(8) how well bottom plugged <i>Video</i>			
DRILLERS REMARKS:			

CODED

If well telescopes please sketch and show depths.

GROUND LEVEL

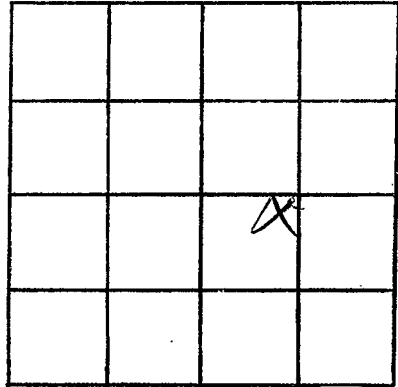

SECTION 12

Please indicate well location X.

ADDITIONAL INFORMATION

If more than one screen,
show locations of each on sketch.