

MISSISSIPPI
BOARD OF WATER COMMISSIONERS
416 North State Street
Jackson, Mississippi 39201

CODED

WATER WELL DRILLERS LOG

PERRY
D 30
5-15-72

5-15-1972 date well completed
Robertson, S firm name
Perry county well located

LANDOWNER: Mrs. J. E. Sigaret

description of fomations encountered

from to

At 3 Richton Miss

Sandy Clay	0	9
Red Clay	9	21
Sticky Silt Clay	21	54
White Sand	54	68
Blue Clay	68	92
Sand + Clay	92	126
White Clay	126	154
C & B Sand	154	180

(mailing address)

WELL LOCATION:

sec. 2 T 4 N R 11 E
S W
3 miles SE of Richton
(distance) (direction) (nearest town)

WELL PURPOSE:

(home, irrigation, municipal, industrial)

WELL COMPLETION DATA:

- (1) diameter (inches) 4"
- (2) total depth (feet) 180
- (3) static water level (feet) 160 below top of ground.
- (4) casing PVC, 160, (material) (depth)
4" (size) if telescope see back.
- (5) screen 10, 170 (length) (depth to top)
4" (size) PVC (material)
- (6) pump 1, 750HR (HP) (yield gpm)
Sub (type power)
- (7) electric log (yes or no)
- (organization running log)
- (8) how well bottom plugged none

CODED


SEP 28 1972

DRILLERS REMARKS:

MISSISSIPPI
BOARD OF WATER COMMISSIONERS
JACKSON, MISSISSIPPI

If well telescopes please sketch and show depths.

GROUND LEVEL

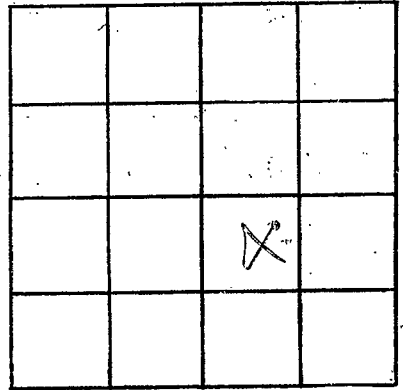

SECTION 2

Please indicate well location X.

ADDITIONAL INFORMATION

If more than one screen, show locations of each on sketch.