

Perry
D 35
6-8-73

MISSISSIPPI
BOARD OF WATER COMMISSIONERS
416 North State Street
Jackson, Mississippi 39201

CODED

WATER WELL DRILLERS LOG

6-8-73 date well completed 1973 firm name General Drilling for Perry county well located Perry

LANDOWNER R.C. Hall
R.F.D. 3
Richmond, Miss.
Richmond, Miss.
(mailing address)

WELL LOCATION:
sec. 2 T 4 N 1 R 11 E
5 miles (distance) NE (direction) of Richmond, Miss. (nearest town)

WELL PURPOSE: Home
(home, irrigation, municipal, industrial)


WELL COMPLETION DATA:
(1) diameter (inches) 2 1/2"
(2) total depth (feet) 85 ft
(3) static water level (feet) 16 ft below top of ground.
(4) casing plastic, 80 ft (material) (depth)
2 1/2" (size) if telescope see back.
(5) screen 5 ft, 85 ft (length) (depth to top)
2 1/2" (size), plastic (material)
(6) pump 1 (HP) 900 (yield gpm)
port (type power)
(7) electric log (yes or no)
(organization running log)
(8) how well bottom plugged valve

description of formations encountered	from	to
Clay	0	11
hard & gravel	11	20
fine sand	20	31
hard sand	31	39
coarser sand	39	48
Clay	48	52
streaky s&g	52	61
fine sand	61	72
hard sand	72	76
open gravel & sand	76	85

DRILLERS REMARKS:

If well telescopes please sketch and show depths.

GROUND LEVEL

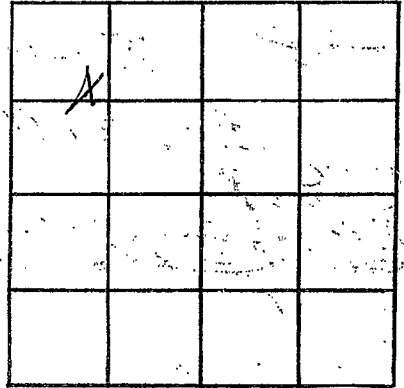

SECTION _____

Please indicate well location X.

ADDITIONAL INFORMATION

If more than one screen,
show locations of each on sketch.