

Perry
D37
10-21-73

MISSISSIPPI
BOARD OF WATER COMMISSIONERS
416 North State Street
Jackson, Mississippi 39201

CODED

WATER WELL DRILLERS LOG

Oct. 21 1973 Cochran Drillers Perry
date well completed firm name county well located


LANDOWNER:	description of formations encountered	from	to
James Strickland Rt. 8, Hattiesburg (mailing address)	top soil	0	3
	red clay	3	10
	red sand	10	22
	brown clay	22	35
	gray clay	35	49
	blue clay	49	75
	beige clay	75	88
	sand	88	120
WELL LOCATION: sec. 5 T 4 N R 11 E S W 10 miles East of Petal (distance) (direction) (nearest town)			
WELL PURPOSE: home (home, irrigation, municipal, industrial)			
WELL COMPLETION DATA:			
(1) diameter (inches) 2"			
(2) total depth (feet) 120'			
(3) static water level (feet) 41' below top of ground.			
(4) casing PVC, 115' (material) (depth)			
(size) if telescope see back.			
(5) screen 5' length, 115' depth to top 2" PVC (size) (material)			
(6) pump 1 HP, 7 (yield gpm) Eleet (type power)			
(7) electric log NO (yes or no)			
(organization running log)			
(8) how well bottom plugged valve			
DRILLERS REMARKS:			

CODED

NOV 5 1973

If well telescopes please sketch and show depths.

GROUND LEVEL

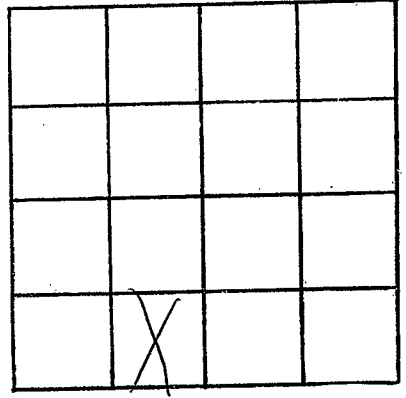

SECTION 5

Please indicate well location X.

ADDITIONAL INFORMATION

If more than one screen, show locations of each on sketch.