

MISSISSIPPI  
BOARD OF WATER COMMISSIONERS  
416 North State Street  
Jackson, Mississippi 39201

CODED

WATER WELL DRILLERS LOG

July 25, 1974 Ray West water wells Perry  
date well completed firm name county well located

LANDOWNER: Bruce Conroy

Rt 3  
Richston  
(mailing address)

WELL LOCATION:  
sec. 12 T. 4 N. R. 11 E  
12 miles E of Richston  
(distance) (direction) (nearest town)

WELL PURPOSE: home  
(home, irrigation, municipal, industrial)

WELL COMPLETION DATA:

- (1) diameter (inches) 4 in
- (2) total depth (feet) 450
- (3) static water level (feet) 110 <sup>below</sup>/<sub>above</sub> top of ground.
- (4) casing Steel pipe (material) 440 (depth)
- (size) if telescope see back.
- (5) screen 10 (length) 440 (depth to top)
- 2 (size) Steel (material)
- (6) pump 3/4 (HP) 20 (yield gpm)
- REA (type power)
- (7) electric log NO (yes or no)
- (organization running log)
- (8) how well bottom plugged per usual

Description of formations encountered	from	to
Clay	0	10
Sand clay	10	46
Sand	46	70
Sand clay	70	95
Sand gravel	95	214
Blue clay	214	315
Sand fine	315	340
Blue clay	340	375
Sand	375	395
Clay	395	410
Sand	410	450


CODED

RECEIVED  
AUG - 8 1974

DRILLERS REMARKS:

If well telescopes please sketch and show depths.

GROUND LEVEL

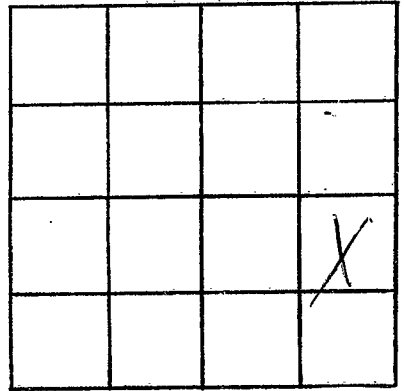

SECTION 12

Please indicate well location X.

ADDITIONAL INFORMATION

If more than one screen, show locations of each on sketch.