

Perry  
D 43  
10-5-74

MISSISSIPPI  
BOARD OF WATER COMMISSIONERS CODED  
416 North State Street  
Jackson, Mississippi 39201

WATER WELL DRILLERS LOG

10-5-74 date well completed  
1974 J. J. Small Drilling Service Perry firm name  
Perry county well located

LANDOWNER:	description of formations encountered	from	to
Alex. Smith P.O. Box 7 Richman, Miss. (mailing address)	hard	0	8
	clay	8	30
	hard gravel & sand	30	110
	hard sand	110	135
<b>WELL LOCATION:</b> sec. 2 T. 4 N. R. 11 E. S W 10 1/2 miles SW of Richman (distance) (direction) (nearest town)			
<b>WELL PURPOSE:</b> (home, irrigation, municipal, industrial)			
<b>WELL COMPLETION DATA:</b>			
(1) diameter (inches) 2 1/2			
(2) total depth (feet) 135 ft			
(3) static water level (feet) 98 ft below top of ground.			
(4) casing plastic, 130 ft (material) (depth)			
2" If telescope see back. (size)			
(5) screen 5 ft, 135 ft (length) (depth to top)			
2" plastic (size) (material)			
(6) pump 2 HP, 10 yield gpm (HP) (yield gpm)			
Auto (type power)			
(7) electric log (yes or no) <input checked="" type="checkbox"/>			
(organization running log)			
(8) how well bottom plugged <input checked="" type="checkbox"/>			
DRILLERS REMARKS:			

CODED


RECEIVED  
RECEIVED

DEC 27 1974

MISS. Bd. OF WATER COMM.

If well telescopes please sketch and show depths.

GROUND LEVEL

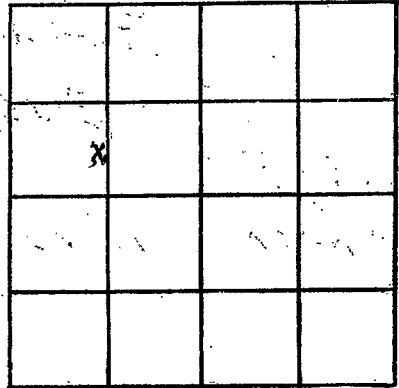

SECTION \_\_\_\_\_

Please indicate well location X.

ADDITIONAL INFORMATION

If more than one screen,  
show locations of each on sketch.