

Derry
 D 450
 5-22-75

MISSISSIPPI
 BOARD OF WATER COMMISSIONERS
 416 North State Street
 Jackson, Mississippi 39201

CODED

WATER WELL DRILLERS LOG

5-22-75 date well completed
 1975 Hurrell Drilling Co firm name
 Derry county well located

LANDOWNER: John D Beasley
 P.O. Box 1
 Richton Miss -
 (mailing address)

description of formations encountered	from	to
clay	0	12
gravel	12	25

WELL LOCATION:
 sec. 2 T. 4 N. R. 11 E 13φ
 S W
 7 miles W of Richton
 (distance) (direction) (nearest town)

Sea level to top	35	42
------------------	----	----

WELL PURPOSE: haul
 (home, irrigation, municipal, industrial)


- WELL COMPLETION DATA:
- (1) diameter (inches) 2"
 - (2) total depth (feet) 72 ft
 - (3) static water level (feet) 24 below top of ground.
 - (4) casing plastic 67 ft
 (material) (depth)
2" if telescope see back.
 (size)
 - (5) screen 5 ft 72 ft
 (length) (depth to top)
2" plastic
 (size) (material)
 - (6) pump 1 900 gpm
 (HP) (yield gpm)
jet
 (type power)
 - (7) electric log
 (yes or no)
✓
 (organization running log)
 - (8) how well bottom plugged valve

RECEIVED
 JUN 18 1975

DRILLERS REMARKS:

If well telescopes please sketch and show depths.

GROUND LEVEL

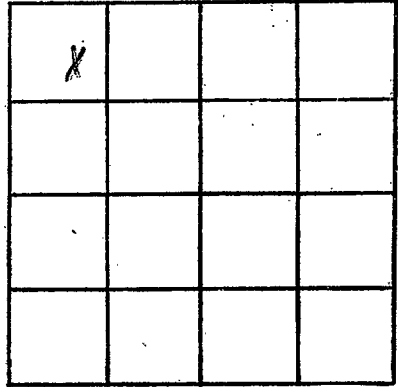

SECTION _____

Please indicate well location X.

ADDITIONAL INFORMATION

If more than one screen, show locations of each on sketch.