

Perry  
 D46  
 3/30/78  
 Elmer #124

MISSISSIPPI  
 BOARD OF WATER COMMISSIONERS  
 416 North State Street  
 Jackson, Mississippi 39201

COCEU

WATER WELL DRILLERS LOG

MARCH 30 1978 YARNER DRILLING SERVICE PERRY  
 date well completed firm name county well located

LANDOWNER: RUNNELSTOWN  
UTILITY DISTRICT, WATER  
WELL # 2  
 (mailing address)  
 WELL LOCATION: NE 1/4 SW 1/4  
 sec. 12 T. 4N R. 11E  
 (distance) miles (direction) of (nearest town)

description of formations encountered	from	to
TOP SOIL	0	3
SANDY CLAY	3	10
SAND w/CLAY streaks	10	35
SAND	35	58
CLAY STREAKS + SAND	58	126
SAND	126	197
CLAY	197	284
SAND, fine	284	308
CLAY	308	382
SAND	382	391
SANDY CLAY	391	402
SAND	402	420
CLAY	420	480
SAND	480	510
CLAY	510	540
SAND	540	577
CLAY	577	597
SAND w/CLAY streaks	597	668
CLAY	668	705

WELL PURPOSE:  
 (home, irrigation, municipal, industrial)

- WELL COMPLETION DATA:
- (1) diameter (inches) 8 5/8"
  - (2) total depth (feet) 512'
  - (3) static water level (feet) 91 below above top of ground.
  - (4) casing Steel 472'  
 (material) (depth)  
8 5/8"  
 (size) If telescope see back.
  - (5) screen 30' 482'  
 (length) (depth to top)  
6" 304 S.S. (0.010)  
 (size) (material)
  - (6) pump 20 150  
 (HP) (yield gpm)  
Elect.  
 (type power)
  - (7) electric log YES  
 (yes or no)  
MGS  
 (organization running log)
  - (8) how well bottom plugged BACK  
WASH VALVE

RECEIVED


APR - 6 1978

MISS. BD. OF WATER COMM.

DRILLERS REMARKS:

If well telescopes please sketch and show depths.

GROUND LEVEL

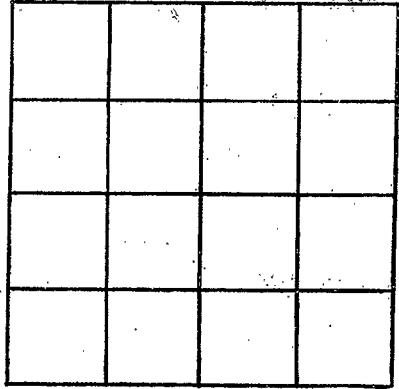

SECTION \_\_\_\_\_

Please indicate well location X.

ADDITIONAL INFORMATION

If more than one screen,  
show locations of each on sketch.