

Perry
D-47

1-3-80

MISSISSIPPI
BOARD OF WATER COMMISSIONERS
416 North State Street
Jackson, Mississippi 39201

CODED

WATER WELL DRILLERS LOG

1-3-80 Griner Drilling Perry

date well completed

firm name

county well located

LANDOWNER:

Exchange Oil & Gas
1600 Bank of New Orleans
1010 Common St
New Orleans, La.
(mailing address)

description of formations encountered

from

to

clay + sand	0	392
sand + gravel	392	413
sand + clay	413	434
sand	434	455
clay + sand	455	616

WELL LOCATION: 2250'S 41820' W

Sec. 11 T. 4 N. R. 11 E. of NE 1/4

Runnelstown
(distance) miles (direction) of (nearest town)

WELL PURPOSE: oil field supply
(home, irrigation, municipal, industrial)

WELL COMPLETION DATA:

- (1) diameter (inches) 3"
- (2) total depth (feet) 616'
- (3) static water level (feet) 200' below above top of ground.
- (4) casing steel 441'
(material) (depth)
3"
(size) if telescope see back.
- (5) screen 42' 399'
(length) (depth to top)
3" perforated
(size) (material)
- (6) pump 70
(HP) (yield gpm)
AC
(type power)
- (7) electric log —
(yes or no)
—
(organization running log)

(8) how well bottom plugged orange

DRILLERS REMARKS:


DEPT. OF NATURAL RESOURCES
BUREAU OF LAND & WATER RESOURCES

JAN 24 1980

RECEIVED

If well telescopes please sketch and show depths.

GROUND LEVEL

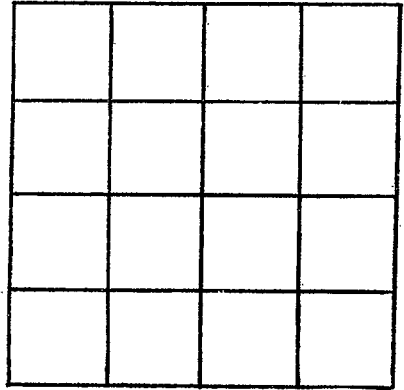

SECTION _____

Please indicate well location X.

ADDITIONAL INFORMATION

If more than one screen,
show locations of each on sketch.