

D48
 Perry
 3-8-84

MISSISSIPPI
 BOARD OF WATER COMMISSIONERS
 416 North State Street
 Jackson, Mississippi 39201

CODED

WATER WELL DRILLERS LOG

MARCH 8 1984 ROY WEST DRUG PERRY
 date well completed firm name county well located

LANDOWNER:	description of formations encountered	from	to
J.M. CONWAY			
RT3 RICHTON MS (mailing address)	SAND	55	116
WELL LOCATION: sec. <u>2</u> T. <u>4</u> N. R. <u>11</u> E S W	CLAY	116	117
<u>10</u> miles <u>SE</u> of <u>RUNNELS</u> (distance) (direction) (nearest town)	CRAVEL	117	134
WELL PURPOSE: (home, irrigation, municipal, industrial)	CLAY	134	163
WELL COMPLETION DATA: (1) diameter (inches) <u>4"</u>	SAND	163	169
(2) total depth (feet) <u>530'</u>	CLAY	169	196
(3) static water level (feet) <u>91'</u> below above top of ground.	SAND STRKS	196	199
(4) casing <u>PVC 525'</u> (material) (depth)	CLAY	199	225
(size) if telescope see back.	SAND	225	227
(5) screen <u>5'</u> <u>525'</u> (length) (depth to top)	CLAY	227	266
<u>2"</u> <u>SS</u> (size) (material)	SAND	266	268
(6) pump <u>1</u> <u>6</u> (HP) (yield gpm)	SAND STRKS	268	278
<u>REA</u> (type power)	CLAY	278	282
(7) electric log <u>NO</u> (yes or no)	SAND	282	314
(organization running log)	HARD CLAY	314	319
(8) how well bottom plugged <u>WASH VALVE</u>	SAND STRKS	319	323
DRILLERS REMARKS:	CLAY	323	341
	LIMESTONE	341	350
	CLAY	350	396
	LIMESTONE	396	400
	CLAY	400	435
	SAND	435	443
	STREAKY SAND	443	464
	CLAY	464	503
	SAND	503	530


DEPT. OF NATURAL RESOURCES
 BUREAU OF LAND & WATER RESOURCES

MAR 16 1984

RECEIVED

If well telescopes please sketch and show depths.

GROUND LEVEL

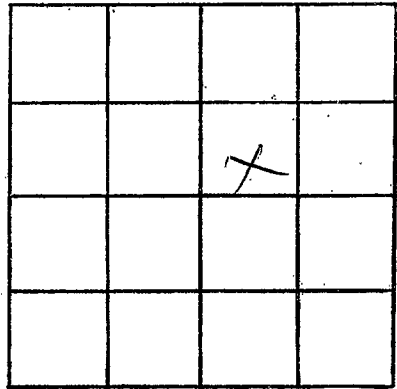

SECTION 2

Please indicate well location X.

ADDITIONAL INFORMATION

If more than one screen,
show locations of each on sketch.