County: <u>Perry</u> Permit #: Driller: <u>James M. Wells</u> Date drilling completed: <u>5-6-16</u> Mississippi D	TE WELL REPORT Part 1 Driller's Log Department of Environmental Quality of Land and Water Resources P.O. Box 2309 Jackson, MS 39225-2309 (601)961-5210 (601)360-0535 (fax)	For Office Use Only: Well #: Aquifer: E-Log #:
State Law requires that this report be prepared l Department at the above address within 30 days	of completion of arilling of the well o	r borehole.
Well Owner Information (Landowner if borehole is not for a water well) Owner Name: Vance Simmons	312(44) Well or Bore Latitude: <u>31°20,738</u> Lon	hole Location 21 gitude: 89°08,458
Mailing Address:	Method of Lat/Long (check one)	: Conventional Survey,
10 Brady Rd.	USGS quad, Hand-held GF	
Petal M5 3946 City State Zip Co	5 NE 1/2 N 11/4, Sec_	CTHN RILL
Telephone No. (601) 447-5111	$\frac{12}{(Distance)} \text{ Miles } \frac{1}{(Direction)} \text{ of }$	(Nearest Town)
We Date drilling started: <u>5-6-16</u> Date drilling comple	ll / Borehole Data	
Name of organization running log(s): Purpose of borehole (circle one) Water Wel Geote Seismic Survey Ot If drilling is not related to water we	and development: <u>Granul</u> Gamma Ray Density Sonic Neutron	Cther:
Purpose of Well (circle all applicable): Home Industri Other (describe):	rial Public Supply Irrigation Fis	h Culture
If a flowing well, method of flow regulation: Valve	Other (describe)	
Static Water Level:feet [above or be (circle one)	low] land surface Date measured:	5-6-16
Method of measurement (circle one): Steel tape Elect	Tic tape Air line Other (describe)	
Well depth: 80 Well grouted to a depth of: 10	feet Type of grout (circle one)	Pat Cement Rontarity III
casing length:feet Casing diameter: _		
Screen length:feet Screen diameter:		
	th: Fromfeet to	For feet
ype of completion (circle all applicable): Gravel packet		Natural Development
Other (describe):		JUN 2 9 2016
op of lap pipe or reduction in casing:fee		
If telescoped or more that	n one screen, describe on next page	By OLWI

4 ,

Form: OLWR-SWR-1A (4/13)

2

County:	Perry	_
Permit #:	(

٠

 
For Office Use Only:

Well #: _____

The sketch below only required for water wells

Description of formations encountered must be provided for all wells and boreholes, unless specifically exempted by regulations

If well telescopes, show depths on sketch. Ground Level



From (depth)	To (<i>depth</i>)
Ground level	
1	55
55	80
•)	
	Ground level

If more than one screen, show location of each on sketch

Sketch the property layout and include the following:	
1) the well location	
2) any permanent structures on the property that may aid in locating the well3) any roads, power lines, or other items that may aid in locating the property and the well	
4) north arrow	
comper x well	
Camper	
1 7 1	
	Received
Priveway	TIECEIVEU
	JUN 2 9 2016
	JUN 29 2010
	By OLWR
Landowner Name: Vance Simmons	Dy OLWA
I HEREBY CERTIFY that the well/borehole was drilled, constructed, and completed in	accordance with all applicable
requirements of the Mississippi Department of Environmental Quality and the Mississip if applicable, and state laws.	pi Department of Health regulations,
James M. Wells 00005889 627-16 Jan	a milalle
Print Name of Responsible Licensee and License No. Date	Signature of Licensee

Form: OLWR-SWR-1A (4/13)

	STATE WELL REPORT		
County: Yerry	Part 2	For Office Use Only:	
Permit #	Pump Installer's Completion Report Mississippi Department of Environmental Quality	Well #:	
Driller: Dames M. Wells	Office of Land and Water Resources	Well #	
Date completed: 3-le-16	P.O. Box 2309 Jackson, MS 39225-2309	Aquifer:	
Copy information from block on Part 1	(601)961-5210		
	(601) 360-0535 (fax)	un installar A conv of Part 1	
of the report must be attached and both	d by a licensed water well contractor or a licensed put purts filed with the Department at the above address v	within 30 days of well completion.	
Well Owner Informati	ion Well Location		
Owner Name: Vance Simm			
Mailing Address:	Method of Lat/Long (check one	e): Conventional Survey,	
10 Brady Rd.	USGS quad, Hand-held G	PS, Survey-grade GPS	
City State	<u>39465</u> <u> </u>	T R	
		ofR (Nearest Town)	
Telephone No. 601, 447-511	(Distance) (Direction)	(Nedrest Town)	
	Pump Type (circle one)		
Submersible Turbine Air Lift Centrifugal Flowing Well Jet Piston Rotary Other (describe):			
Date Pump Installed: 5-10-11	Rated Pump Capacity:	Gallons Per Minute	
Is This Pump (circle one): New Re	paired Replacement		
	Power Type (circle one)		
Electric Diesel Gasoline Natural Gas	s Tractor PTO Windmill Other (describe):		
Horse Power Rating of Motor:	Setting Depth: 60 feet Numbe	r of Stages: <u>7</u>	
	Pump Test Data for Non Flowing Well		
	Duration of Pump Test (minin		
Static Water Level (A): 40 Fee	et Below Land Surface Pumping Water Level (B):	60 Feet Below Land Surface	
Drawdown [(B) - (A)]: 47 20	_Feet Below Land Surface Test Pumping Rate:	<u> </u>	
	teel tape Electric tape Air line Other (describe):		
	Pump Test Data for Flowing Well		
Measured shut in head:fee	t.		
Well yieldedGPM with a	drawdown of feet after	_hours of pumping	
	Meter Installation		
Meter Manufacturer:	Meter Serial Number:	n-noived	
Meter Model Number/Name:	Type of Meter:	Heceivea	
Totalizer Register Unit and Multiplier F	Meter Serial Number: Type of Meter: Factor (AF x .001, gal x 1000, etc):	HIN 2 9 2016	
Installation Date:	Meter installed by:		
is This Meter (circle one): New Re	Meter installed by:	By OLWH	
Important: By submitting the above i	nformation you are certifying that this meter was inst ural wells, a list of approved meters is on the MDEQ	talled to manufacturer standards.	
I HEREBY CERTIFY that the above state	ements are true to the best of my knowledge.		
		a mult	
James M. Wells 0000	5889 6-27.16 Jac- Date Sign	ature of Pump Installer	

Form: OLWR-SWR-1B (4/13)