

PERRY
J. H. A. D.
2-25-76

MISSISSIPPI
 BOARD OF WATER COMMISSIONERS
 416 North State Street
 Jackson, Mississippi 39201

WATER WELL DRILLERS LOG

2-25 1976 Journal Drillers Perry
 date well completed firm name county well located

LANDOWNER Eric Bell Reese
Rt. 2, Box 1
near Opalata, Miss.
 (mailing address)

description of formations encountered	from	to
<u>fine sand</u>	<u>0</u>	<u>25</u>
<u>clay</u>	<u>25</u>	<u>30</u>
<u>fine sand</u>	<u>30</u>	<u>40</u>
<u>fine gravelly sand</u>	<u>40</u>	<u>85</u>

WELL LOCATION:
 sec. 3 T. 4 N. R. 11 E.
15 miles SE Rural
 (distance) (direction) (nearest town)

WELL PURPOSE: Home
 (home, irrigation, municipal, industrial)


- WELL COMPLETION DATA:
- (1) diameter (inches) 2"
 - (2) total depth (feet) 85 ft
 - (3) static water level (feet) 10 ft below top of ground.
 - (4) casing Plastic (material) 80 ft (depth)
 - 2" (size) if telescope see back.
 - (5) screen 5 ft (length) 85 ft (depth to top)
 - 2" (size) Plastic (material)
 - (6) pump 1 (HP) 12 (yield gpm)
 - Gas (type power)
 - (7) electric log ✓ (yes or no)
 - (organization running log)
 - (8) how well bottom plugged John

DRILLERS REMARKS:

REGISTERED
 APR - 2 1976

If well telescopes please sketch and show depths.

GROUND LEVEL

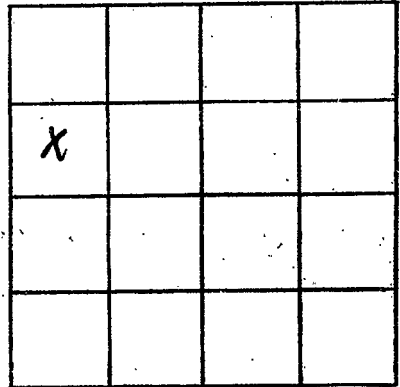

SECTION _____

Please indicate well location X.

ADDITIONAL INFORMATION

If more than one screen, show locations of each on sketch.