

PERRY
D 2001
2-26-76

MISSISSIPPI
BOARD OF WATER COMMISSIONERS
416 North State Street
Jackson, Mississippi 39201

WATER WELL DRILLERS LOG

2-26-76 136 1976 *Sumner Drilling Co Perry*
date well completed firm name county well located

LANDOWNER: *J.W. Mervin*
P.O. # 1
Miss Augusta Miss
(mailing address)

WELL LOCATION:
sec. 2 T. 4 N. R. 11 E.
S. W.
18 miles *NE* of *Forest*
(distance) (direction) (nearest town)


WELL PURPOSE: *drone*
(home, irrigation, municipal, industrial)

- WELL COMPLETION DATA:
- (1) diameter (inches) 2"
 - (2) total depth (feet) 42 ft
 - (3) static water level (feet) 18 ft below top of ground.
 - (4) casing plastic, 37 ft (material) (depth)
2" (size) If telescope see back.
 - (5) screen 5 ft, 42 ft (length) (depth to top)
2", plastic (size) (material)
 - (6) pump 1 11 (HP) (yield gpm)
pit (type power)
 - (7) electric log (yes or no)
(organization running log)
 - (8) how well bottom plugged valve

description of formations encountered	from	to
<i>clay</i>	<i>0</i>	<i>10</i>
<i>fine sand</i>	<i>10</i>	<i>15</i>
<i>clay</i>	<i>15</i>	<i>25</i>
<i>fine sand</i>	<i>25</i>	<i>30</i>
<i>hard sand</i>	<i>30</i>	<i>42</i>

3 mi. SW
Rural Station


DRILLERS REMARKS:

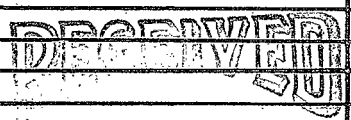

APR - 2 1976

If well telescopes please sketch and show depths.

GROUND LEVEL

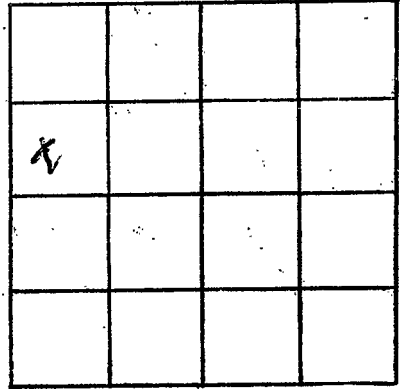

SECTION _____

Please indicate well location X.

ADDITIONAL INFORMATION

If more than one screen, show locations of each on sketch.