

PERRY
D 2002
3-18-76

MISSISSIPPI
BOARD OF WATER COMMISSIONERS
416 North State Street
Jackson, Mississippi 39201

WATER WELL DRILLERS LOG

March 18 1976 ^{13φ} Cochran Drilling Co. Perry
date well completed firm name county well located

LANDOWNER:
Larry Creel
Rt 8 Hattiesburg, MS.
(mailing address)

description of formations encountered	from	to
top soil	0	3
white clay	3	12
red sand	12	19
gray clay	19	28
blue clay	28	32
sand	32	50

WELL LOCATION:
sec. 9 T 4 N R 11 E
4 miles 5 of ^{Perry} (nearest town)

WELL PURPOSE: none
(home, irrigation, municipal, industrial)


- WELL COMPLETION DATA:
- (1) diameter (inches) 2"
 - (2) total depth (feet) 50'
 - (3) static water level (feet) 18' ^{below} top of ground.
 - (4) casing PVC, 45' (material), (depth)
2" (size) if telescope see back.
 - (5) screen 5' 45' (length), (depth to top)
2" PVC (size), (material)
 - (6) pump 1 (HP), 13 (yield gpm)
elec (type power)
 - (7) electric log no (yes or no)
 - (organization running log)
 - (8) how well bottom plugged Value

DRILLERS REMARKS:

RECEIVED
APR - 5 1976

If well telescopes please sketch and show depths.

GROUND LEVEL

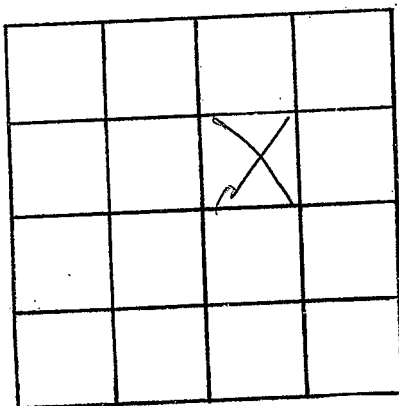

SECTION 9

Please indicate well location X.

ADDITIONAL INFORMATION

If more than one screen, show locations of each on sketch.