

Perry
D 2003
5-10-77

C. P. CLARK
MISSISSIPPI WATER WELL DRILLING
BOARD OF WATER COMMISSIONERS ROUTE 2
416 North State Street LAUREL, MISS. 39440
130 Jackson, Mississippi 39201

WATER WELL DRILLERS LOG

5/10 1977 C.P. Clark Perry
date well completed firm name county well located


LANDOWNER: <u>John Craft</u>	description of formations encountered	from	to
Pl # <u>8</u> <u>Richard Miss</u> (mailing address)			
WELL LOCATION: sec. <u>15</u> <u>4</u> (N) R. <u>11</u> E <u>5</u> miles <u>S</u> of <u>Pinnelton</u> (distance) (direction) (nearest town)	<u>Sandy Clay</u>	<u>0</u>	<u>7</u>
	<u>Sand</u>	<u>7</u>	<u>20</u>
	<u>Sand & Gravel</u>	<u>20</u>	<u>49</u>
WELL PURPOSE: <u>Home</u> (home, irrigation, municipal, industrial)			
WELL COMPLETION DATA:			
(1) diameter (inches) <u>2</u>			
(2) total depth (feet) <u>49</u>			
(3) static water level (feet) <u>10</u> below top of ground.			
(4) casing <u>Galv I</u> <u>42</u> (material) (depth)			
(size) If telescope see back.			
(5) screen <u>5</u> <u>42</u> (length) (depth to top)			
<u>1 1/4</u> <u>S.S. 206</u> (size) (material)			
(6) pump _____ (HP) _____ (yield gpm)			
<u>1100 S.P.</u> (type power)			
(7) electric log <u>No</u> (yes or no)			
(organization running log)			
(8) how well bottom plugged <u>B.W.U.</u>			
DRILLERS REMARKS: <u>Customer to get own pump well pumped 15 P.M with air</u>			

RECEIVED
MAY 13 1977

MISSISSIPPI BOARD OF WATER COMMISSIONERS

If well telescopes please sketch and show depths.

GROUND LEVEL

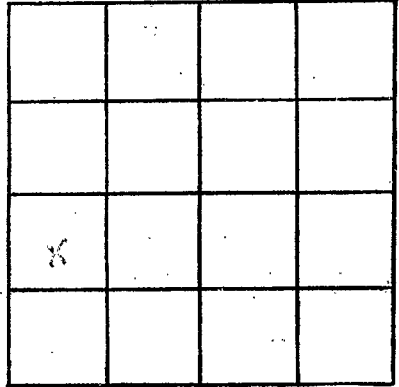

SECTION 15

Please indicate well location X.

ADDITIONAL INFORMATION

Lined area for additional information.

If more than one screen, show locations of each on sketch.