

Perry
D 2004
5-17-77

MISSISSIPPI
 BOARD OF WATER COMMISSIONERS
 416 North State Street
 Jackson, Mississippi 39201

WATER WELL DRILLERS LOG

5-17 date well completed 1977 General Drilling for Perry firm name county well located

LANDOWNER:	description of formations encountered	from	to
<u>Larons</u>			
<u>R. F. R. [unclear]</u>	<u>clay</u>	<u>0</u>	<u>22</u>
<u>Ridgeman miss</u> (mailing address)	<u>gravel</u>	<u>22</u>	<u>35</u>
	<u>clay</u>	<u>35</u>	<u>85</u>
	<u>Old Method</u>	<u>85</u>	<u>112</u>

WELL LOCATION:
 sec 2 T 4 N R 11 E
6 miles S.W. of Ridgeman
 (distance) (direction) (nearest town)

WELL PURPOSE: Home
 (home, irrigation, municipal, industrial)


- WELL COMPLETION DATA:
- (1) diameter (inches) 2"
 - (2) total depth (feet) 112 ft
 - (3) static water level (feet) 84 ft ^{below} _{above} top of ground.
 - (4) casing Aluminum 107 ft
 (material) (depth)
2" if telescope see back.
 (size)
 - (5) screen 8 ft, 102 ft
 (length) (depth to top)
2" Aluminum
 (size) (material)
 - (6) pump 1 6
 (HP) (yield gpm)
1/2
 (type power)
 - (7) electric log ✓
 (yes or no)
✓
 (organization running log)
 - (8) how well bottom plugged shut

DRILLERS REMARKS:

RECEIVED
 AUG 4 1977
 MISS. BD. OF WATER COMMISSIONERS

If well telescopes please sketch and show depths.

GROUND LEVEL

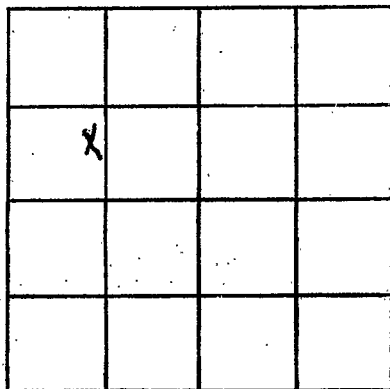

SECTION _____

Please indicate well location X.

ADDITIONAL INFORMATION

If more than one screen,
show locations of each on sketch.