

MISSISSIPPI DEPARTMENT OF NATURAL RESOURCES

Bureau of Land and Water Resources

Southport Mall

P.O. Box 10631

Jackson, Mississippi 39209

WATER WELL DRILLERS LOG

Perry
D 2007
10-7-81

Oct 7 1981 Cochran Brothers Drilling Service Perry
date well completed firm name county well located

LANDOWNER:
Syrl Freeman
Rt 12 Hattiesburg
(mailing address)

description of formations encountered	from	to
<u>TOP Soil</u>	<u>0</u>	<u>1</u>
<u>Red clay</u>	<u>1</u>	<u>6</u>
<u>Red sand</u>	<u>6</u>	<u>10</u>
<u>sand</u>	<u>10</u>	<u>25</u>

WELL LOCATION:
sec. 8 T. 4 N. R. 11 E.
S. W.
3 miles NE of Indian Springs
(distance) (direction) (nearest town)

WELL PURPOSE: None
(None) Irrigation, municipal, industrial

- WELL COMPLETION DATA:
- (1) diameter (inches) 2"
 - (2) total depth (feet) 25'
 - (3) static water level (feet) 8' below above top of ground.
 - (4) casing PVC, 20'
(material) (depth)
 if telescope see back.
(size)
 - (5) screen 5', 20'
(length) (depth to top)
2", PVC
(size) (material)
 - (6) pump 1/2, 5
(HP) (yield gpm)
Elec
(type power)
 - (7) electric log no
(yes or no)

(organization running log)
 - (8) how well bottom plugged None


DRILLERS REMARKS:

DEPT. OF NATURAL RESOURCES
BUREAU OF LAND & WATER RESOURCES

DEC - 3 1981
RECEIVED

If well telescopes please sketch and show depths.

GROUND LEVEL

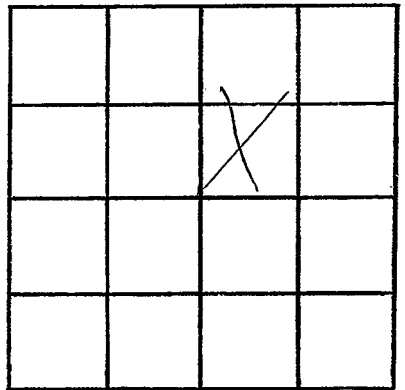

SECTION 8

Please indicate well location X.

ADDITIONAL INFORMATION

If more than one screen,
show locations of each on sketch.