

MISSISSIPPI DEPARTMENT OF NATURAL RESOURCES
Bureau of Land and Water Resources
 Southport Mall
 P.O. Box 10631
 Jackson, Mississippi 39209
WATER WELL DRILLERS LOG

Perry
D
2008

March 10 - 1982 in Cochran Brothers Drilling Co. PERRY
 date well completed firm name county well located

LANDOWNER:
Calvin Howard
Rt 12 Hattiesburg
 (mailing address)

description of formations encountered	from	to
	Top soil	0
brown clay	2	9
Red sand	9	19
sand & gravel	19	62

WELL LOCATION:
 sec. 16 4 N S R. 11 E W
5 miles S of Ridgeland
 (distance) (direction) (nearest town)

WELL PURPOSE: home
 (home, irrigation, municipal, industrial)

- WELL COMPLETION DATA:**
- diameter (inches) 2"
 - total depth (feet) 62'
 - static water level (feet) 28' below above top of ground.
 - casing PVC, 57'
 (material) (depth)
 (size) if telescope see back.
 - screen 5', 57'
 (length) (depth to top)
2", PVC
 (size) (material)
 - pump 3/4, 6
 (HP) (yield gpm)
Elect.
 (type power)
 - electric log no
 (yes or no)
 - (organization running log)
 - how well bottom plugged valve

DRILLERS REMARKS:


SEPT. OF NATURAL RESOURCES
 BUREAU OF LAND & WATER RESOURCES

APR 12 1982

RECEIVED

If well telescopes please sketch and show depths.

GROUND LEVEL

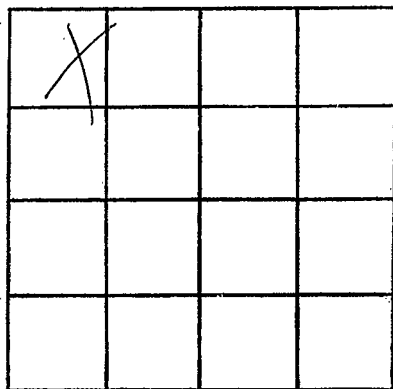

SECTION 16

Please indicate well location X.

ADDITIONAL INFORMATION

If more than one screen,
show locations of each on sketch.