

MISSISSIPPI DEPARTMENT OF NATURAL RESOURCES
Bureau of Land and Water Resources
 Southport Mall
 P.O. Box 10631
 Jackson, Mississippi 39209
WATER WELL DRILLERS LOG

Perry
D
2009

July 16, 1982 date well completed Pechum Bros Drilling firm name Perry county well located

LANDOWNER:	description of formations encountered	from	to
<u>BOB Hogwood</u> <u>Rt 12 Nettiesboro</u> (mailing address)	<u>TOP Soil</u> <u>sandy clay</u> <u>GRAY clay</u>	<u>0</u> <u>1</u> <u>10</u>	<u>1</u> <u>10</u> <u>40</u>
WELL LOCATION: sec. <u>22</u> T. <u>4</u> N. R. <u>11</u> E <u>6</u> miles <u>5</u> of <u>Runklestown</u> (distance) (direction) (nearest town)	<u>Blue clay</u> <u>sand + gravel</u>	<u>48</u> <u>118</u>	<u>118</u> <u>130</u>
WELL PURPOSE: <u>Home</u> (home, irrigation, municipal, industrial)			
WELL COMPLETION DATA:			
(1) diameter (inches) <u>2"</u>			
(2) total depth (feet) <u>130'</u>			
(3) static water level (feet) <u>18'</u> <u>below</u> top of ground.			
(4) casing <u>PVC</u> , <u>120'</u> (material) (depth)			
_____ if telescope see back. (size)			
(5) screen <u>10'</u> <u>120'</u> (length) (depth to top)			
<u>2"</u> <u>PVC</u> (size) (material)			
(6) pump <u>1</u> <u>8</u> (HP) (yield gpm)			
<u>Elec</u> (type power)			
(7) electric log _____ (yes or no)			
_____ <u>value</u> (organization running log)			
(8) how well bottom plugged _____			
DRILLERS REMARKS:			


DEPT. OF NATURAL RESOURCES
 BUREAU OF LAND & WATER RESOURCES

OCT - 4 1982

RECEIVED

If well telescopes please sketch and show depths.

GROUND LEVEL

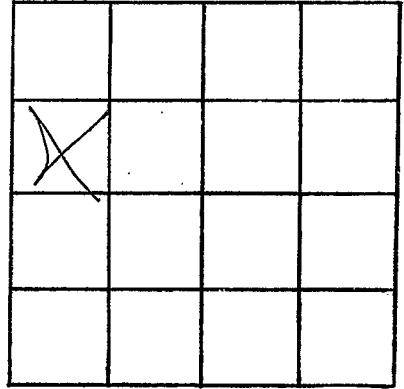

SECTION 22

Please indicate well location X.

ADDITIONAL INFORMATION

If more than one screen,
show locations of each on sketch.