

MISSISSIPPI DEPARTMENT OF NATURAL RESOURCES

Bureau of Land and Water Resources

Southport Mall

P.O. Box 10631

Jackson, Mississippi 39209

WATER WELL DRILLERS LOG

Perry
 D
 2011

July 1 - 1982 date well completed Cochran Geo Drilling firm name Perry county well located

LANDOWNER:	description of formations encountered	from	to
W. Lowery	TOP Soil	0	1
Rt. 12 Hattiesburg (mailing address)	Red clay	1	3
	Red earth	3	70
	gray clay	70	105
	sand	105	120
	blue clay sand	120	120

WELL LOCATION:
 sec. 22 T 4 N R 11 E W
 6 miles S of Rinkeston
 (distance) (direction) (nearest town)

WELL PURPOSE:
 (home, irrigation, municipal, industrial)

- WELL COMPLETION DATA:
- (1) diameter (inches) 4 1/2
 - (2) total depth (feet) 120'
 - (3) static water level (feet) 22' below top of ground.
 - (4) casing PVC 110' (material) (depth)
 - (size) 10' 10' If telescope see back.
 - (5) screen (length) (depth to top)
 - (size) 4 1/2" PVC (material)
 - (6) pump 3/4 sub 20' (HP) (yield gpm)
 - (type power) Elec
 - (7) electric log no (yes or no)
 - (organization running log)
 - (8) how well bottom plugged VMLC

DEPT. OF NATURAL RESOURCES
 BUREAU OF LAND & WATER RESOURCES


OCT - 4 1982

RECEIVED

DRILLERS REMARKS:

If well telescopes please
sketch and show depths.

GROUND LEVEL

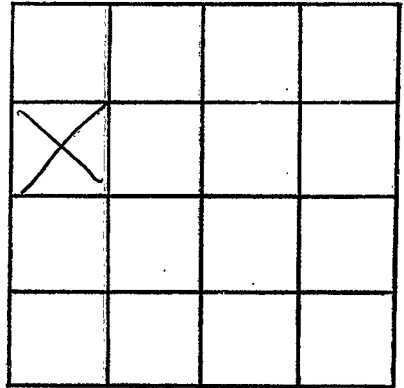

SECTION 22

Please indicate well location X.

ADDITIONAL INFORMATION

If more than one screen,
show locations of each on sketch.