

MISSISSIPPI DEPARTMENT OF NATURAL RESOURCES
Bureau of Land and Water Resources
 Southport Mall
 P.O. Box 10631
 Jackson, Mississippi 39209
WATER WELL DRILLERS LOG

Perry
D. 2012

June 14 - 88 date well completed Cochem Bore Drilling Service firm name FERRY county well located

LANDOWNER:	description of formations encountered	from	to
<u>Herbie Cleeman</u> <u>PO Box 12 B - Hattiesburg</u> (mailing address)	<u>Top Soil</u>	<u>0</u>	<u>2</u>
	<u>Red clay</u>	<u>2</u>	<u>9</u>
	<u>sand & Corauke</u>	<u>9</u>	<u>18</u>
	<u>GRAY clay</u>	<u>18</u>	<u>31</u>
	<u>Blue clay</u>	<u>31</u>	<u>105</u>
	<u>sand</u>	<u>105</u>	<u>150</u>
WELL LOCATION: sec. <u>22</u> T. <u>4N</u> S. R. <u>11E</u> <u>6</u> miles <u>S</u> of <u>Ridgeway</u> (distance) (direction) (nearest town)			
WELL PURPOSE: <u>Home</u> (home, irrigation, municipal, industrial)			
WELL COMPLETION DATA:			
(1) diameter (inches) <u>2"</u>			
(2) total depth (feet) <u>130'</u>			
(3) static water level (feet) <u>18</u> <u>below</u> above top of ground.			
(4) casing <u>PVC, 120'</u> (material) (depth)			
If telescope see back. (size)			
(5) screen <u>10'</u> , <u>120'</u> (length) (depth to top)			
<u>2"</u> , <u>PVC</u> (size) (material)			
(6) pump <u>1</u> <u>9</u> (HP) (yield gpm)			
<u>Elec</u> (type power)			
(7) electric log <u>no</u> (yes or no)			
(organization running log)			
(8) how well bottom plugged <u>valve</u>			
DRILLERS REMARKS:			


DEPT. OF NATURAL RESOURCES
 BUREAU OF LAND & WATER RESOURCES

OCT - 4 1988

RECEIVED

If well telescopes please sketch and show depths.

GROUND LEVEL

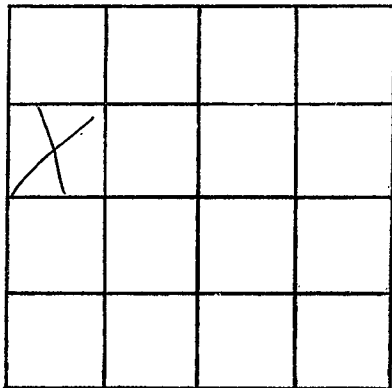

SECTION 22

Please indicate well location X.

ADDITIONAL INFORMATION

If more than one screen,
show locations of each on sketch.