

MISSISSIPPI DEPARTMENT OF NATURAL RESOURCES

Bureau of Land and Water Resources

Southport Mall

P.O. Box 10631

Jackson, Mississippi 39209

WATER WELL DRILLERS LOG

<i>Perry</i>
D
2013

Jan-12-1984 date well completed     39 Cochran Water Well Service firm name     Perry county well located

LANDOWNER:	description of formations encountered	from	to
Bobby Hegwood	Top Soil	0	2
Rt 12 Nattiesburg (mailing address)	Red clay	2	5
WELL LOCATION:	Red sand	5	9
sec. 21 T 4 N R 11 E S W	gray clay	9	28
5 miles S of Runnestown (distance) (direction) (nearest town)	sand	28	42
WELL PURPOSE:			
(home, irrigation, municipal, industrial)			
WELL COMPLETION DATA:			
(1) diameter (inches) 2'			
(2) total depth (feet) 42'			
(3) static water level (feet) 2' below top of ground.			
(4) casing PVC, 38' (material) (depth)			
(size) if telescope see back.			
(5) screen 5' 38' (length) (depth to top)			
2" PVC (size) (material)			
(6) pump 1 7 (HP) (yield gpm)			
Elec. (type power)			
(7) electric log (yes or no) (organization running log)			
(8) how well bottom plugged valve			
DRILLERS REMARKS:			


DEPT. OF NATURAL RESOURCES  
BUREAU OF LAND & WATER RESOURCES

JUN - 1 1984

RECEIVED

If well telescopes please sketch and show depths.

GROUND LEVEL

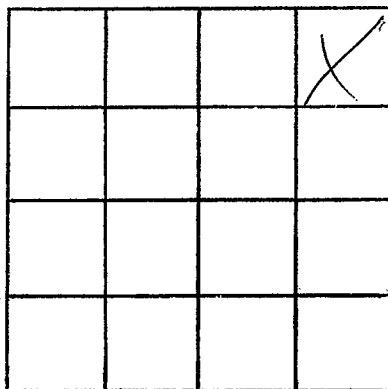

SECTION 21

Please indicate well location X.

ADDITIONAL INFORMATION

If more than one screen,  
show locations of each on sketch.