

Perry

~~D 33~~

D 2018

8-25-80

MISSISSIPPI
 BOARD OF WATER COMMISSIONERS
 416 North State Street
 Jackson, Mississippi 39201

WATER WELL DRILLERS LOG

August 25 1980 Cochran Brothers Drilling Co. Perry
 date well completed firm name county well located


LANDOWNER:	description of formations encountered	from	to
Scott Taylor			
Box 12 Hazlebury (mailing address)	Top soil	0	2
	red clay	2	7
	red sand	7	13
	fine sand	13	38
	blue clay	38	44
	gray clay	44	56
	white clay	56	91
	sand & gravel	91	125
WELL LOCATION:			
sec. 17 T 4 (N) R 11 E			
4 miles N of Broken Springs (distance) (direction) (nearest town)			
WELL PURPOSE: home (home, irrigation, municipal, industrial)			
WELL COMPLETION DATA:			
(1) diameter (inches) 2"			
(2) total depth (feet) 125'			
(3) static water level (feet) 35' below top of ground.			
(4) casing PVC, 115' (material) (depth)			
(size) if telescope see back.			
(5) screen 10' 115' (length) (depth to top)			
2" PVC (size) (material)			
(6) pump 1 1/2 HP 7 (yield gpm)			
elec (type power)			
(7) electric log no (yes or no)			
(organization running log)			
(8) how well bottom plugged solve			
DRILLERS REMARKS:			

DEPT. OF NATURAL RESOURCES
 BUREAU OF LAND & WATER RESOURCES

SEP 4 - 1980
 RECEIVED

If well telescopes please sketch and show depths.

GROUND LEVEL

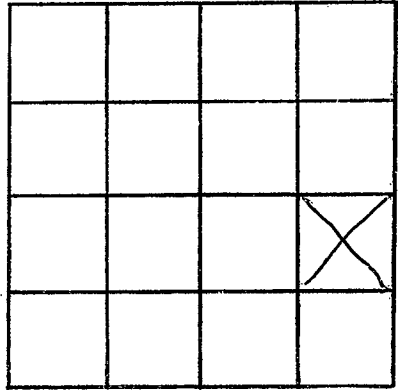

SECTION 17

Please indicate well location X.

ADDITIONAL INFORMATION

If more than one screen,
show locations of each on sketch.