

MISSISSIPPI DEPARTMENT OF NATURAL RESOURCES

Bureau of Land and Water Resources

P.O. Box 10631

Jackson, Mississippi 39209

WATER WELL DRILLERS LOG

COUNTY WELL LOCATED <i>Perry</i>	
WELL NUMBER <i>D 209</i>	CODED
DATE WELL COMPLETED <i>April 16-1990</i>	

PERMIT NUMBER
NAME OF DRILLING FIRM <i>Coahoma Water Well Ser</i>

NAME & MAILING ADDRESS OF LANDOWNER <i>Jimmy Stewart</i>		
<i>RD 2</i>		
<i>Petal mo. 39465</i>		
WELL LOCATION: SEC	TOWNSHIP	RANGE
<i>17</i>	<i>4 N</i>	<i>11 E</i>
DISTANCE	DIRECTION	NEAREST TOWN
<i>5</i> Miles	<i>S-W</i>	<i>Punahocuss</i>
OTHER LANDMARK <i>(Circled 2)</i>		
WELL PURPOSE: Home Irrigation, Municipal, Industrial, Fish Pond, etc.		

PUMP DATA		
PUMP TYPE (Circle One): Submersible, Turbine, <u>Jet</u> Flowing Well, Other (Describe) _____		
POWER TYPE (Circle One): <u>Electric</u> , Tractor, Diesel, Gasoline, Butane, Other (Describe) _____ H/P _____		
Pump Capacity (GPM)	No. of Stages	Setting Depth
<i>7</i>	<i>3</i>	<i>80</i> FT.
PUMP TEST		
Well yielded _____ GPM with a drawdown of _____ ft. after _____ hours of pumping		

WELL DATA		
Well Depth <i>90'</i>	Casing Diameter (In.) <i>2"</i>	Casing Length (Ft.) <i>80</i>
Type of Casing <i>PVC</i>	Hole Depth <i>90'</i>	Depth to Static Water Level <i>68'</i>
TYPE OF COMPLETION: (Circle One or More): <u>Gravel Packed</u> , Underreamed, Telescoped, <u>Natural Development</u> , Open Hole, Other (Describe) _____		
Top of Lap Pipe or Reduction in Casing		
FEET		IF TELESCOPED OR MORE THAN ONE SCREEN: USE BACK PAGE

LOG DATA	
TYPE OF LOG RUN (Circle One): Electric, Gamma Ray, Density, Sonic, <u>No Log Run</u> , Other (Describe) _____	
Name of Organization Running Log	

SCREEN DATA		
Diameter - Inches <i>2</i>	Length - Feet <i>10</i>	Slot Size - Inches <i>10</i>
Screen Type <i>PVC</i>	Depth to Bottom - Feet <i>90</i>	

GEOLOGIC DATA (Office Use Only)			
Surface Elev.	Geologic Unit	Unit Thickness	Depth to Top
Subs. SWL	Date	Analysis	Aquifer Test


Driller's Remarks

DESCRIPTION OF FORMATIONS ENCOUNTERED	FROM	TO	FORMATIONS (Continued)	FROM	TO
<i>TOP Soil</i>	<i>0</i>	<i>2</i>	<div style="font-size: 2em; font-weight: bold; border: 2px solid black; padding: 5px; display: inline-block;">RECEIVED</div> <div style="font-size: 1.5em; font-weight: bold;">MAY 16 1990</div> <div style="font-size: 0.8em;">Department of Natural Resources Bureau of Land & Water Resources</div>		
<i>Red clay</i>	<i>2</i>	<i>6</i>			
<i>Red sand</i>	<i>6</i>	<i>18</i>			
<i>Gray clay</i>	<i>18</i>	<i>63</i>			
<i>sand</i>	<i>63</i>	<i>90</i>			

IF MORE SPACE IS NEEDED, USE BACK

If well telescopes please sketch and show depths.

GROUND LEVEL

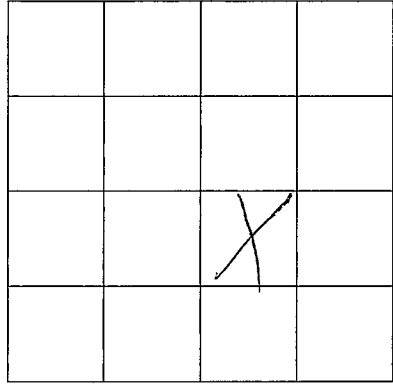

SECTION 17

Please indicate well location X.

ADDITIONAL INFORMATION

Lined area for additional information.

00000000

If more than one screen, show location of each on sketch.