

MISSISSIPPI DEPARTMENT OF NATURAL RESOURCES

Bureau of Land and Water Resources

Southport Mall

P.O. Box 10631

Jackson, Mississippi 39209

WATER WELL DRILLERS LOG

Gerry
5
D 2020

Nov. 26, 1982 date well completed Cochran Bore Drilling Service firm name Perry county well located

LANDOWNER:	description of formations encountered	from	to
Victor Rustin Rt 12 Hattiesburg (mailing address)			
WELL LOCATION:	TOP soil	0	2
sec. <u>17</u> T <u>4</u> N <u>11</u> R <u>11</u> E	Red clay	2	4
<u>3</u> miles N-E of <u>Imperial</u>	Gray clay	4	10
(distance) (direction) (nearest town)	Sand	10	58
WELL PURPOSE:			
(Home, irrigation, municipal, industrial)			
WELL COMPLETION DATA:			
(1) diameter (inches) <u>2"</u>			
(2) total depth (feet) <u>58'</u>			
(3) static water level (feet) <u>18'</u> below above top of ground.			
(4) casing <u>PVC</u> <u>58'</u> (material) (depth)			
(size) if telescope see back.			
(5) screen <u>5'</u> <u>58'</u> (length) (depth to top)			
<u>2"</u> <u>PVC</u> (size) (material)			
(6) pump <u>1</u> <u>7</u> (HP) (yield gpm)			
<u>E. loc</u> (type power)			
(7) electric log <u>NO</u> (yes or no)			
(organization running log)			
(8) how well bottom plugged <u>NAV/12</u>			
DRILLERS REMARKS:			


DEPT. OF NATURAL RESOURCES
BUREAU OF LAND & WATER RESOURCES

FEB 16 1983

RECEIVED

If well telescopes please sketch and show depths.

GROUND LEVEL

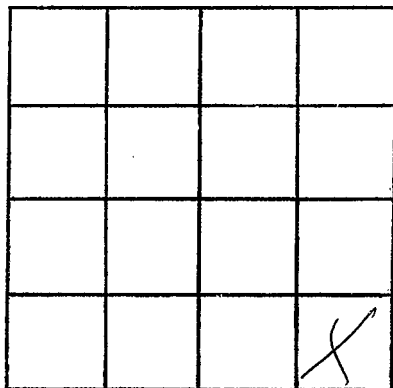

SECTION 17

Please indicate well location X.

ADDITIONAL INFORMATION

If more than one screen,
show locations of each on sketch.