

MISSISSIPPI DEPARTMENT OF ENVIRONMENTAL QUALITY

Office of Land and Water Resources

P. O. Box 10631
Jackson, MS 39289-0631
WATER WELL DRILLERS LOG

COUNTY WELL LOCATED <u>Perry</u>	
WELL NUMBER <u>D 2022</u>	CODED
DATE WELL COMPLETED <u>11-10-98</u>	

PERMIT NUMBER <u>0-586</u>
NAME OF DRILLING FIRM <u>James wells</u>
<u>Water Well Ser.</u>

NAME & MAILING ADDRESS OF LANDOWNER <u>Joe Powers</u>		
<u>170 Freeman Rd.</u>		
<u>Richton MS 39476</u>		
WELL LOCATION: SEC	TOWNSHIP	RANGE
<u>17</u>	<u>4</u>	<u>11</u>
DISTANCE	DIRECTION	NEAREST TOWN
<u>5</u> Miles	<u>South</u>	<u>Pannelstown</u>
OTHER LANDMARK		
WELL PURPOSE: <input checked="" type="checkbox"/> Home <input type="checkbox"/> Irrigation, <input type="checkbox"/> Municipal, <input type="checkbox"/> Industrial, <input type="checkbox"/> Fish Pond, etc.		

PUMP DATA		
PUMP TYPE (Circle One): Submersible, Turbine, <input checked="" type="radio"/> Jet, Flowing Well, Other (Describe) _____		
POWER TYPE (Circle One): <input checked="" type="radio"/> Electric, Tractor, Diesel, Gasoline, Butane, Other (Describe) _____ H/P <u>1</u>		
Pump Capacity (GPM)	No. of Stages	Setting Depth
		_____ FT.
PUMP TEST		
Well yielded <u>10</u> GPM with a drawdown of _____ ft. after _____ hours of pumping		

WELL DATA		
Well Depth <u>95 Ft</u>	Casing Diameter (In.) <u>2 in</u>	Casing Length (Ft.) <u>85</u>
Type of Casing <u>PVC</u>	Hole Depth <u>95 Ft</u>	Depth to Static Water Level <u>40</u>
TYPE OF COMPLETION: (Circle One or More): <input checked="" type="checkbox"/> Gravel Packed, <input type="checkbox"/> Underreamed, <input type="checkbox"/> Telescoped, <input type="checkbox"/> Natural Development, <input type="checkbox"/> Open Hole, <input type="checkbox"/> Other		

LOG DATA	
TYPE OF LOG RUN (Circle One): No Log Run, Electric, Gamma Ray, Density, Sonic, Neutron, Other (Describe) _____	
Name of Organization Running Log	

WELL GROUTED TO A DEPTH OF <u>10</u> FEET
Type Grout (circle one): Cement, Bentonite, or Mix

GEOLOGIC DATA (Office Use Only)			
Surface Elev.	Geologic Unit	Unit Thickness	Depth to Top
Subs. SWL	Date	Analysis	Aquifer Test
Driller's Remarks			
Top of Lap Pipe or Reduction in Casing			
FEET	IF TELESCOPED OR MORE THAN ONE SCREEN: USE BACK PAGE		

SCREEN DATA		
Diameter - Inches <u>2 in</u>	Length - Feet <u>210</u>	Slot Size - Inches <u>0885</u>
Screen Type <u>PVC Slot</u>	Depth to Bottom - Feet <u>85-95</u>	

DESCRIPTION OF FORMATIONS ENCOUNTERED	FROM	TO
<u>Top Sed</u>	<u>0</u>	<u>2</u>
<u>Clay</u>	<u>2</u>	<u>60</u>
<u>Sand</u>	<u>60</u>	<u>95</u>

FORMATIONS (Continued)		FROM	TO
RECEIVED			
JUN 17 1999			
Dept of Environmental Quality Office of Land & Water Resources			
IF MORE SPACE IS NEEDED, USE BACK			


If well telescopes please sketch and show depths.

GROUND LEVEL

SECTION _____

Please indicate well location X.

ADDITIONAL INFORMATION

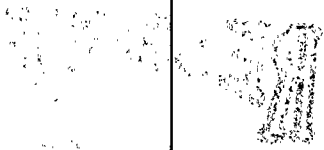

If more than one screen,
show location of each on sketch.