

PERRY

MISSISSIPPI BOARD OF WATER COMMISSIONERS

E2

9-7-60

WATER WELL DRILLERS LOG

E 300


Date: Sept 7, 1960, Driller: Tina County: PERRY
(Name)

| | | | |
|---|---|------------------------|---------------|
| (1) Owner of Land: <u>A.P. Robain</u> (Name) | Description & Color of Materials Sand, Clay, Red Clay, Shell, etc. | Thick- ness Feet | Depth Feet |
| <u>Richton Mississippi</u> (Address) | <u>0-95 Blue Clay</u> | | |
| (2) Location: <u>NW 1/4, NW 1/4, Sec. 23, T4R10</u> | <u>95-125 Sand</u> | | |
| <u>5</u> miles <u>South</u> of <u>Richton</u> (distance) (direction) (Nearest Town) | <u>125-143 p. gravel</u> | | |
| (3) Topography: <u>Hilly</u> (Hilly) (Flat) (Level) | | | |
| (4) Purpose of Well: <u>INDUSTRIAL</u> (Domestic Irrigation Municipal, Industrial, Other) | | | |

Information upon completion of well:

- (1) Diameter 2" inches.
- (2) Total Depth 143 feet.
- (3) Water Level 115 feet below top of ground.
- (4) Cased to 138, Size 2"
- (5) Screen: Size 2", Length 5'
- (6) Were any formations sealed against pollution?
yes, no.

If YES depth of formation _____
Why _____
Drillers Remarks: _____

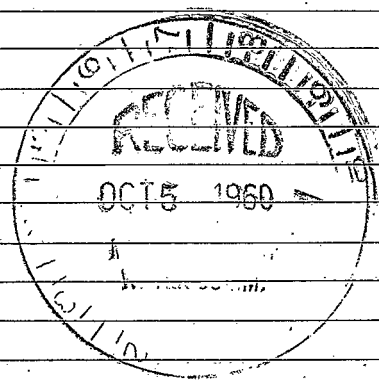

(Use Back Side)

Well No.

1912

1912

