

Perry
E 13
1-5-70

MISSISSIPPI
BOARD OF WATER COMMISSIONERS
416 North State Street
Jackson, Mississippi 39201

CODED

WATER WELL DRILLERS LOG

Jan 5, 1970 19 Cochran & Rayburn Dg Co Perry
date well completed firm name county well located

LANDOWNER:
Eugene Shourd
Route 3 Richton Miss
(mailing address)

description of formations encountered	from	to
Red Clay	0	8
Sand	8	14
Blue Clay	14	28
Sand	28	48

WELL LOCATION:
sec. 8 T 4 N R 10 E
8 miles SE of Rumelton
(distance) (direction) (nearest town)

CODED

WELL PURPOSE: Home
(home, irrigation, municipal, industrial)

- WELL COMPLETION DATA:
- (1) diameter (inches) 2
 - (2) total depth (feet) 45
 - (3) static water level (feet) 25 ^{below} above top of ground.
 - (4) casing PVC, 40 (material) (depth)
(size) If telescope see back.
 - (5) screen 5, 40 (length) (depth to top)
2, PVC (size) (material)
 - (6) pump 1/2, 5 (HP) (yield gpm)
Elec. (type power)
 - (7) electric log No (yes or no)
(organization running log)
 - (8) how well bottom plugged Valve


MAR 6 1970

DRILLERS REMARKS:
Cochran

MISS. BD. OF
WATER COMM.

If well telescopes please sketch and show depths.

GROUND LEVEL

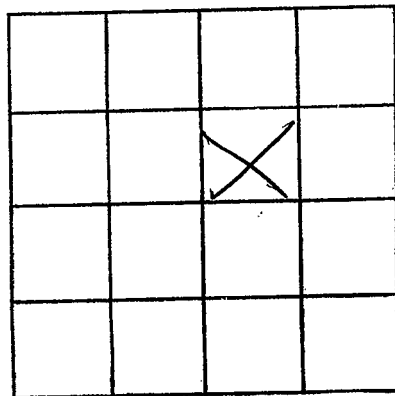

SECTION 2

Please indicate well location X.

ADDITIONAL INFORMATION

If more than one screen, show locations of each on sketch.