

Perry
E 14
4-21-70

MISSISSIPPI
BOARD OF WATER COMMISSIONERS
416 North State Street
Jackson, Mississippi 39201

CODED

WATER WELL DRILLERS LOG

4-21-1970 date well completed S.H.A. firm name Perry county well located

LANDOWNER: Sead Mickelson

description of formations encountered

from to

Richard, Miss.
(mailing address)

<u>Sandy Surface</u>	0	6
<u>Well Clay</u>	6	11
<u>Sand with fine</u>	11	19
<u>Blue Clay</u>	19	67
<u>Sand & clay</u>	67	82
<u>Peaty sand</u>	82	90
<u>Heater Jack</u>	90	92
<u>Band</u>	92	96
<u>Blue Clay</u>	96	101
<u>White, Red & brown</u>	101	192
<u>Sandy clay</u>	192	196
<u>Steel</u>	196	210

WELL LOCATION:

sec 3 T. 4 N. R. 10 E.
3 miles W of Richard
(distance) (direction) (nearest town)

WELL PURPOSE: Test Tank
(home, irrigation, municipal, industrial)

WELL COMPLETION DATA:

- (1) diameter (inches) 4 1/2" Test Hole
- (2) total depth (feet) _____
- (3) static water level (feet) _____ below above top of ground.
- (4) casing _____ (material) _____ (depth) _____
_____ if telescope see back.
(size)
- (5) screen _____ (length) _____ (depth to top) _____
(size) _____ (material)
- (6) pump _____ (HP) _____ (yield gpm) _____
(type power)
- (7) electric log M.H.S. (yes or no)
(organization running log)
- (8) how well bottom plugged _____

Set pipe at 96 ft
but no water


DRILLERS REMARKS:

7 1970

MISS. Bd. of
WATER COMMISSIONERS

If well telescopes please
sketch and show depths.

GROUND LEVEL

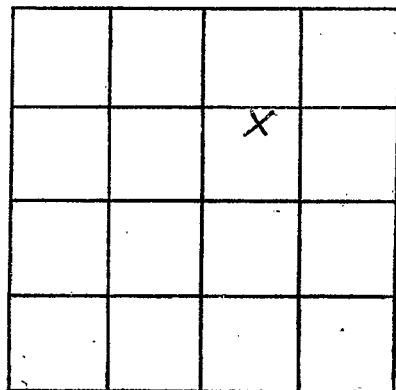

SECTION 3

Please indicate well location X.

ADDITIONAL INFORMATION

If more than one screen,
show locations of each on sketch.