

Perry Co  
 E 16  
 5-12-70

MISSISSIPPI  
 BOARD OF WATER COMMISSIONERS  
 416 North State Street  
 Jackson, Mississippi 39201


WATER WELL DRILLERS LOG

May 12 - 1970 Sims Drilling Perry  
 date well completed firm name county well located

LANDOWNER: <u>Burnice Hawthorn</u>	description of formations encountered	from	to
<u>Burnice Hawthorn</u>			
<u>Rt. 3, Richton, Miss.</u> (mailing address)	<u>red clay</u>	<u>0</u>	<u>18</u>
	<u>sand</u>	<u>18</u>	<u>22</u>
	<u>blue clay</u>	<u>22</u>	<u>65</u>
	<u>sand</u>	<u>65</u>	<u>122</u>
WELL LOCATION: sec <u>19</u> T <u>4</u> N <u>5</u> R <u>10</u> E <u>5</u> <u>116</u> <u>8</u> miles <u>N</u> of <u>New Augusta</u> (distance) (direction) (nearest town)			
WELL PURPOSE: <u>home</u> (home, irrigation, municipal, industrial)			
WELL COMPLETION DATA:			
(1) diameter (inches) <u>2 in</u>			
(2) total depth (feet) <u>122 ft</u>			
(3) static water level (feet) <u>94</u> <u>below</u> top of ground. above			
(4) casing <u>plastic</u> , <u>117</u> (material) (depth)			
<u>      </u> if telescope see back. (size)			
(5) screen <u>5 ft</u> , <u>117</u> (length) (depth to top)			
<u>2 in</u> , <u>plastic</u> (size) (material)			
(6) pump <u>1</u> <u>500</u> (HP) (yield gpm)			
<u>electric</u> (type power)			
(7) electric log <u>no</u> (yes or no)			
<u>      </u> (organization running log)			
(8) how well bottom plugged <u>3 ft. valve</u>			
DRILLERS REMARKS:			

If well telescopes please sketch and show depths.

GROUND LEVEL

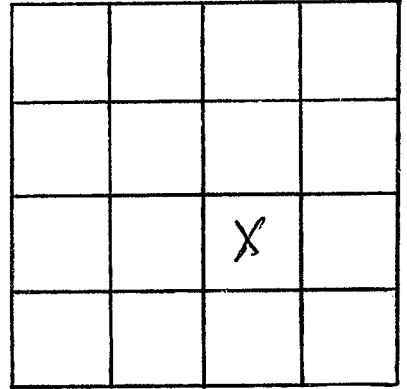

SECTION 19

Please indicate well location X.

ADDITIONAL INFORMATION

If more than one screen, show locations of each on sketch.