

**PERRY**  
**E 18**  
**9-2-71**

MISSISSIPPI  
 BOARD OF WATER COMMISSIONERS  
 416 North State Street  
 Jackson, Mississippi 39201

DEC 6 1971

WATER WELL DRILLERS LOG

**CODED**

Sept 2 1971 Cochran Drilling Inc Perry  
 date well completed firm name county well located

LANDOWNER: J R Smith description of formations encountered from to  
Rt 3 Richton top soil 0 5  
 red clay 5 9  
 gray clay 9 20  
 sand clay 20 32  
 sand 32 45  
 (mailing address)

WELL LOCATION:  
 sec 7 T 4 N R 10  
9 miles E of Perrinton  
 (distance) (direction) (nearest town)

WELL PURPOSE:  
 (home, irrigation, municipal, industrial)

WELL COMPLETION DATA:  
 (1) diameter (inches) 2  
 (2) total depth (feet) 45  
 (3) static water level (feet) 8 below above top of ground.  
 (4) casing PVC 40  
 (material) (depth)

\_\_\_\_\_ If telescope see back.  
 (size)  
 (5) screen 5' 40  
 (length) (depth to top)  
2 PVC  
 (size) (material)

(6) pump \_\_\_\_\_ (HP) \_\_\_\_\_ (yield gpm)  
Elec  
 (type power)

(7) electric log no  
 (yes or no)


\_\_\_\_\_ (organization running log)  
 (8) how well bottom plugged None

DRILLERS REMARKS:  
 \_\_\_\_\_  
 \_\_\_\_\_  
 \_\_\_\_\_

**CODED**

If well telescopes please sketch and show depths.

GROUND LEVEL

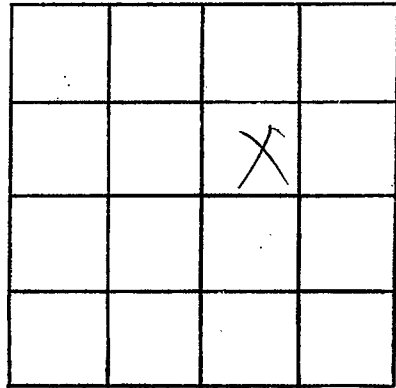

SECTION 7

Please indicate well location X.

ADDITIONAL INFORMATION

Lined area for additional information.

If more than one screen, show locations of each on sketch.