

Perry
E 19
7-29-72

MISSISSIPPI
BOARD OF WATER COMMISSIONERS
416 North State Street
Jackson, Mississippi 39201

CODED

WATER WELL DRILLERS LOG

7-29-72 date well completed 1972 Harvey Raybaudles Perry firm name county well located

LANDOWNER: James F.
Hinton Jr. Box 498
Richton Miss.
(mailing address)

description of formations encountered	from	to
Sandy clay	0	11
Sand	11	31
clay	31	33
Sand	33	43

WELL LOCATION:
sec. 15 T 4 N R 10 E
S W
4 miles NE of Richton
(distance) (direction) (nearest town)

WELL PURPOSE:
(home, irrigation, municipal, industrial)

- WELL COMPLETION DATA:
- (1) diameter (inches) 2"
 - (2) total depth (feet) 43'
 - (3) static water level (feet) 27 below above top of ground.
 - (4) casing PVC 38 (material) (depth)
 - _____ if telescope see back. (size)
 - (5) screen 5' 38' (length) (depth to top)
 - 2" PVC (size) (material)
 - (6) pump 1/2 5 (HP) (yield gpm)
 - 110 (type power)
 - (7) electric log No (yes or no)
 - _____ (organization running log)
 - (8) how well bottom plugged B.P.V.

CODED


AUG - 8 1972

DRILLERS REMARKS:

MISS. BD. OF
WATER COMM.

If well telescopes please
sketch and show depths.

GROUND LEVEL

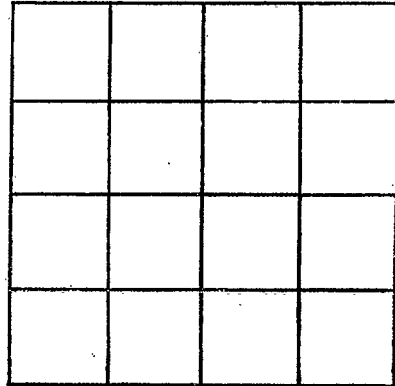

SECTION _____

Please indicate well location X.

ADDITIONAL INFORMATION

If more than one screen,
show locations of each on sketch.