

PERRY
E 20
8-8-72

MISSISSIPPI
BOARD OF WATER COMMISSIONERS
416 North State Street
Jackson, Mississippi 39201

CODED

WATER WELL DRILLERS LOG

August 8 1972 Cochran Drilling Service Perry
date well completed firm name county well located

LANDOWNER:
Jimmie Pope
Rt. 7 Richton
(mailing address)

WELL LOCATION:
sec. 10 T 4 N R 10 E
4 miles S of Richton
(distance) (direction) (nearest town)

WELL PURPOSE: home
(home, irrigation, municipal, industrial)

WELL COMPLETION DATA:

(1) diameter (inches) 2"

(2) total depth (feet) 175'

(3) static water level (feet) 96' below above top of ground.

(4) casing PVC, 165',
(material) (depth)
(size) If telescope see back.

(5) screen 10' 165'
(length) (depth to top)
2" PVC
(size) (material)

(6) pump 1 5
(HP) (yield gpm)
Electric
(type power)

(7) electric log no
(yes or no)

(organization running log)

(8) how well bottom plugged valve

description of formations encountered	from	to
Top soil	0	4
red clay	4	11
red sand	18	22
gray clay	22	66
Blue clay	66	108
Brown clay	108	122
fine sand	122	125
Blue clay	125	165
sand	165	175

CODED


OCT - 5 1972

DRILLERS REMARKS:

MISS. BD. OF
WATER COMM.

If well telescopes please sketch and show depths.

GROUND LEVEL

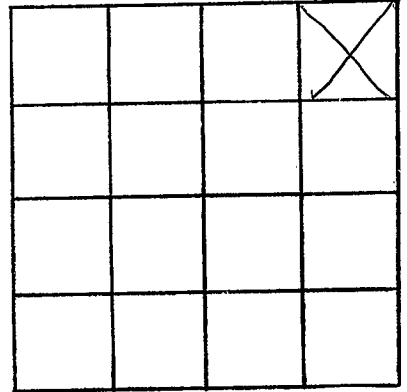

SECTION 10

Please indicate well location X.

ADDITIONAL INFORMATION

Lined area for additional information.

If more than one screen, show locations of each on sketch.