

MISSISSIPPI
BOARD OF WATER COMMISSIONERS
416 North State Street
Jackson, Mississippi 39201

WATER WELL DRILLERS LOG

Perry
E 22
4-1-73

4-1 date well completed 1973 Cochran Drilling Service firm name Perry county well located

LANDOWNER: Marie A. Dike
Route 1, New Augusta
(mailing address)

description of formations encountered	from	to
Top soil	0	4
Red clay	4	9
GRAY clay	9	21
Blue clay	21	36
Sand	36	50

WELL LOCATION:
sec 32 T 4 (N) R 10 E
7 miles ^{S North} of ^{(W) NEW} Augusta
(distance) (direction) (nearest town)

WELL PURPOSE: Home
(home, irrigation, municipal, industrial)

WELL COMPLETION DATA:

(1) diameter (inches) 2"

(2) total depth (feet) 50'

(3) static water level (feet) 11 below top of ground.

(4) casing PVC 45'
(material) (depth)

 if telescope see back.
(size)

(5) screen 5' 45'
(length) (depth to top)

2" PVC
(size) (material)

(6) pump 1 9
(HP) (yield gpm)

Electric
(type power)

(7) electric log no
(yes or no)

(organization running log)

(8) how well bottom plugged valve


COILED

DRILLERS REMARKS:

WELL 1 2 1073

If well telescopes please sketch and show depths.

GROUND LEVEL

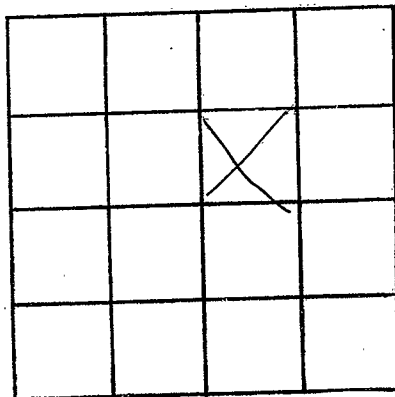

SECTION 32

Please indicate well location X.

ADDITIONAL INFORMATION

If more than one screen, show locations of each on sketch.