

MISSISSIPPI
 BOARD OF WATER COMMISSIONERS
 416 North State Street
 Jackson, Mississippi 39201

CODED

WATER WELL DRILLERS LOG

PERRY
E 23
5-5-73

5-5 19 73 Cochran Drilling Service Perry
 date well completed firm name county well located

LANDOWNER: Sally A. Clark
Route 3 Richton

description of formations encountered	depth	
	from	to
Top soil	0	3
red clay	3	8
red sand	8	15
gray clay	15	29
blue clay	29	38
sand & gravel	38	65

(mailing address)

WELL LOCATION:
 sec. 7 T. 4 N. R. 10 E.
6 miles S of Pannel
 (distance) (direction) (nearest town)

WELL PURPOSE: Home
 (home, irrigation, municipal, industrial)

CODED

WELL COMPLETION DATA:

(1) diameter (inches) 2"

(2) total depth (feet) 65'

(3) static water level (feet) 16 below above top of ground.

(4) casing PVC 60'
 (material) (depth)

 if telescope see back.
 (size)

(5) screen 5' 60'
2" (length) (depth to top)
P.V.C.
 (size) (material)

(6) pump 1 6 1/2
 (HP) (yield gpm)
Electric
 (type power)

(7) electric log no
 (yes or no)

 (organization running log)


(8) how well bottom plugged value

DRILLERS REMARKS:

WELL TO BE

If well telescopes please sketch and show depths.

GROUND LEVEL

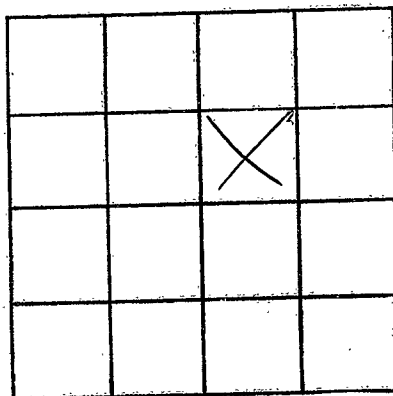

SECTION 7

Please indicate well location X.

ADDITIONAL INFORMATION

If more than one screen, show locations of each on sketch.