

Perry
E25
6-5-74

MISSISSIPPI
BOARD OF WATER COMMISSIONERS CLARK
416 North State Street
Jackson, Mississippi 39201
WATER WELL DRILLING
ROUTE 2
LAUREL, MISS. 39440
WATER WELL DRILLERS LOG CODED

6/5 1974 date well completed
P. P. Clark firm name
Perry county well located

LANDOWNER: Mrs Mable Hunter
Hentonville Miss.

Description of formations encountered	from	to
Sandy Clay	0	8
Sand	8	20

(mailing address)

WELL LOCATION:
sec. 36 T. 4 N. R. 10 E.
S W
2 miles West of Hentonville
(distance) (direction) (nearest town)

CODED

WELL PURPOSE: Home
(home, irrigation, municipal, industrial)

- WELL COMPLETION DATA:
- (1) diameter (inches) 2
 - (2) total depth (feet) 20
 - (3) static water level (feet) 13 below top of ground.
 - (4) casing Galva 15 (material), (depth)
 - (size) if telescope see back.
 - (5) screen 5 15 (length), (depth to top)
1 1/4 SS, 806 (size), (material)
 - (6) pump 1/2 3 (HP), (yield gpm)
1100 (type power)
 - (7) electric log no (yes or no)
 - (organization running log)
 - (8) how well bottom plugged B W U


DRILLERS REMARKS: Used
Customer's old Perless
rod pump

INT. ...
JUN 10 1974

MISS. BD. OF WATER COM.

If well telescopes please sketch and show depths.

GROUND LEVEL

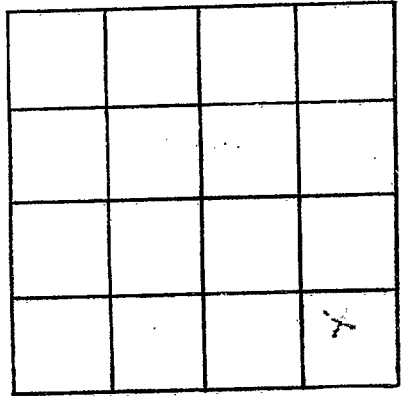

SECTION 76

Please indicate well location X.

ADDITIONAL INFORMATION

If more than one screen, show locations of each on sketch.