

Perry  
E26  
7-26-74

MISSISSIPPI  
BOARD OF WATER COMMISSIONERS **CODED**  
416 North State Street  
Jackson, Mississippi 39201

WATER WELL DRILLERS LOG

July 26 1974 Roy West Water Wells Perry  
date well completed firm name county well located

LANDOWNER: J. McConner  
Pt 2  
Rechtown  
(mailing address)

description of formations encountered	from	to
Sandy clay	0	5
Clay	5	45
Sand	45	52
Clay	52	80
Sand	80	110

WELL LOCATION:  
sec. 31 T 4 N R 10 E  
13 miles E of Rechtown  
(distance) (direction) (nearest town)

WELL PURPOSE: home  
(home, irrigation, municipal, industrial)

- WELL COMPLETION DATA:
- (1) diameter (inches) 2 in
  - (2) total depth (feet) 110
  - (3) static water level (feet) 100 below top of ground.
  - (4) casing galv, 105 (material) (depth)  
if telescope see back. (size)
  - (5) screen 5, 105 (length) (depth to top)  
2 in, St Steel (size) (material)
  - (6) pump 1, 6 (HP) (yield gpm)  
R6A (type power)
  - (7) electric log NO (yes or no)
  - (8) how well bottom plugged wash well

CODED


RECEIVED

AUG - 8 1974

DRILLERS REMARKS:

If well telescopes please sketch and show depths.

GROUND LEVEL

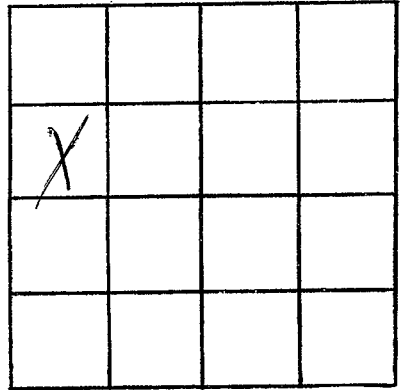

SECTION 13

Please indicate well location X.

ADDITIONAL INFORMATION

If more than one screen, show locations of each on sketch.