

Perry
E27
12-18-74

MISSISSIPPI
BOARD OF WATER COMMISSIONERS
416 North State Street
Jackson, Mississippi 39201

WATER WELL DRILLERS LOG CODED

12-18-74 date well completed
1974 firm name
county well located

LANDOWNER: Publicly owned
R.F.D. #3
Pickens miss.
(mailing address)

description of formations encountered	from	to
<u>hardy clay</u>	<u>0</u>	<u>12</u>
<u>fine sand</u>	<u>12</u>	<u>21</u>
<u>Red sandstone</u>	<u>21</u>	<u>32</u>

WELL LOCATION:
sec. 3 T. 4 N. R. 10 E.
S. W.
8 miles S.W. of Pickens
(distance) (direction) (nearest town)

WELL PURPOSE: Home
(home, irrigation, municipal, industrial)

WELL COMPLETION DATA:

(1) diameter (inches) 2"

(2) total depth (feet) 32 ft

(3) static water level (feet) 11 ft below top of ground.

(4) casing Plastic (material) 27 ft (depth)
2" If telescope see back.
(size)

(5) screen 5 ft (length) (depth to top)
2" (size) Plastic (material)

(6) pump 1/2 (HP) 12 gpm (yield/gpm)
90t (type power)

(7) electric log (yes or no)
(organization running log)

(8) how well bottom plugged blue


DRILLERS REMARKS:

RECEIVED
DEC 27 1974

MISS. BD. OF WATER COMM

If well telescopes please sketch and show depths.

GROUND LEVEL

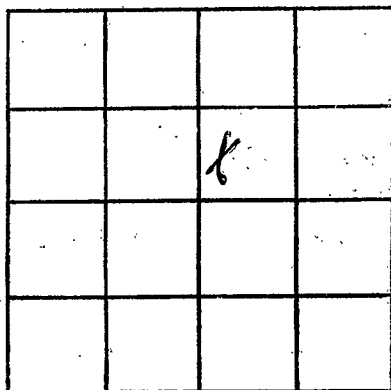

SECTION _____

Please indicate well location X.

ADDITIONAL INFORMATION

If more than one screen,
show locations of each on sketch.