

**PERRY**  
**E 28**  
**3-17-75**

MISSISSIPPI  
 BOARD OF WATER COMMISSIONERS  
 416 North State Street  
 Jackson, Mississippi 39201

CODED

WATER WELL DRILLERS LOG

3-17-75 date well completed      Samuel Perry firm name      Perry county well located

LANDOWNER	description of formations encountered	from	to
<u>Richard Perry</u>	<u>clay</u>	<u>0</u>	<u>15</u>
<u>Rt 27</u>	<u>fine sand</u>	<u>15</u>	<u>35</u>
<u>Richard Perry</u> (mailing address)	<u>sand</u>	<u>35</u>	<u>64</u>
	<u>wood land</u>	<u>44</u>	<u>60</u>

WELL LOCATION:  
 sec 7 T 4 N 1 E R 11 W  
8 miles S of Bayou  
 (distance) (direction) (nearest town)

WELL PURPOSE: Home  
 (home, irrigation, municipal, industrial)

- WELL COMPLETION DATA:
- (1) diameter (inches) 2"
  - (2) total depth (feet) 60 ft
  - (3) static water level (feet) 10 ft below/above top of ground.
  - (4) casing plastic 55 ft  
 (material) (depth)  
2" If telescope see back.  
 (size)
  - (5) screen 5 ft 60 ft  
 (length) (depth to top)  
2" plastic  
 (size) (material)
  - (6) pump 1 800 gpm  
 (HP) (yield gpm)  
jet  
 (type power)
  - (7) electric log ✓  
 (yes or no)  
✓  
 (organization running log)
  - (8) how well bottom plugged valued


REGISTERED  
 DRILLERS  
 APR 15 1975

DRILLERS REMARKS:

MISS. BD. OF WATER COMMISSIONERS

If well telescopes please sketch and show depths.

GROUND LEVEL

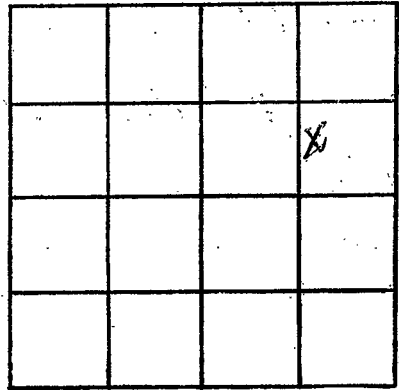

SECTION \_\_\_\_\_

Please indicate well location X.

ADDITIONAL INFORMATION

If more than one screen,  
show locations of each on sketch.